


T. 2 S. R. 3 W. W. M. :

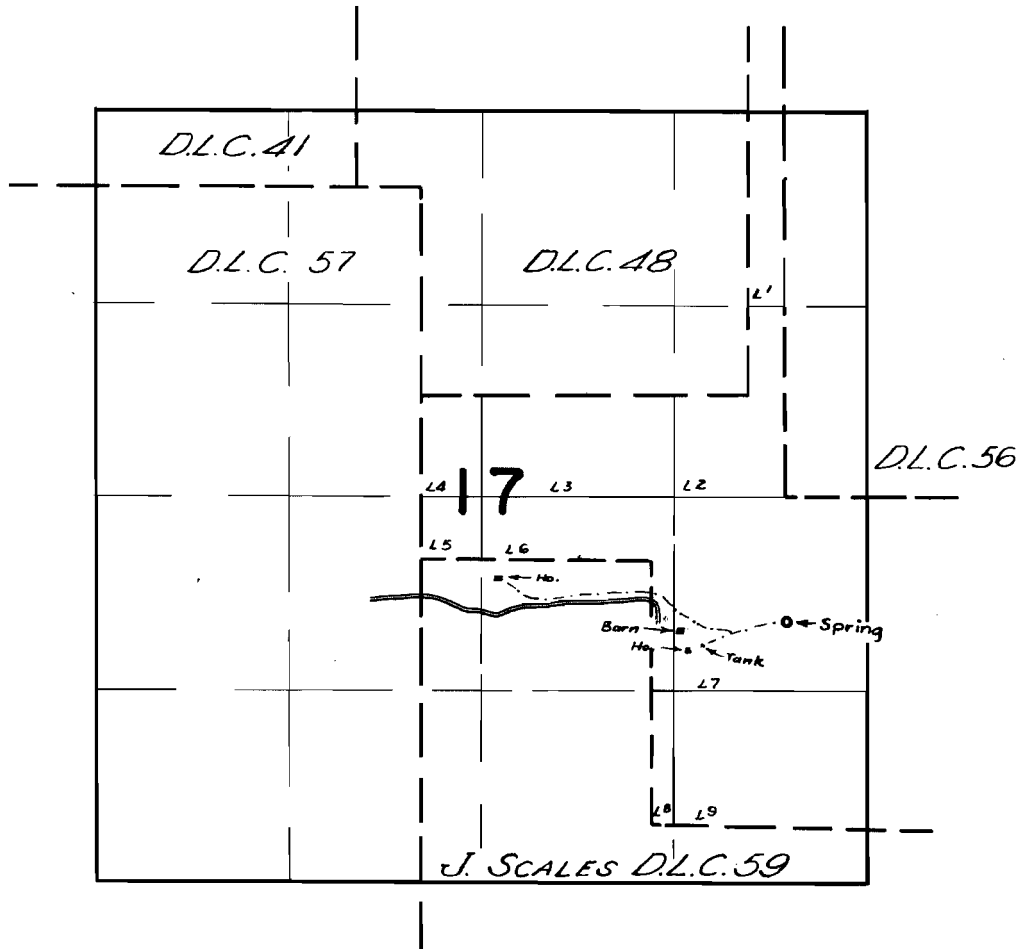

**FINAL PROOF SURVEY**  
UNDER

Application No. 32693 Permit No. 25832  
IN NAME OF

DALE CLAPSHAW

Surveyed APR. 12, 1963, by M. Bish