


T. 5 S. R. 5 W. W.M.

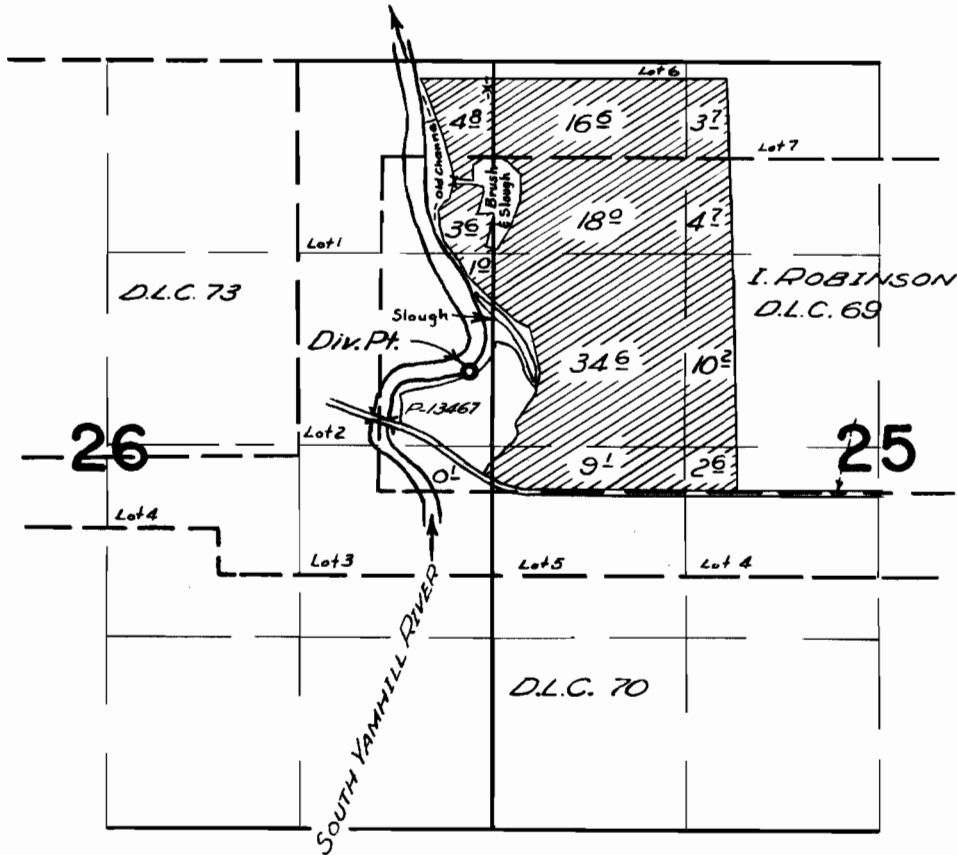

FINAL PROOF SURVEY
UNDER

Application No. 32925 Permit No. 26020
IN NAME OF

NORVAL GOFFENA

Surveyed MAY 17 1963, by m. Bied