


T.5&6S.R.6W.W.M.

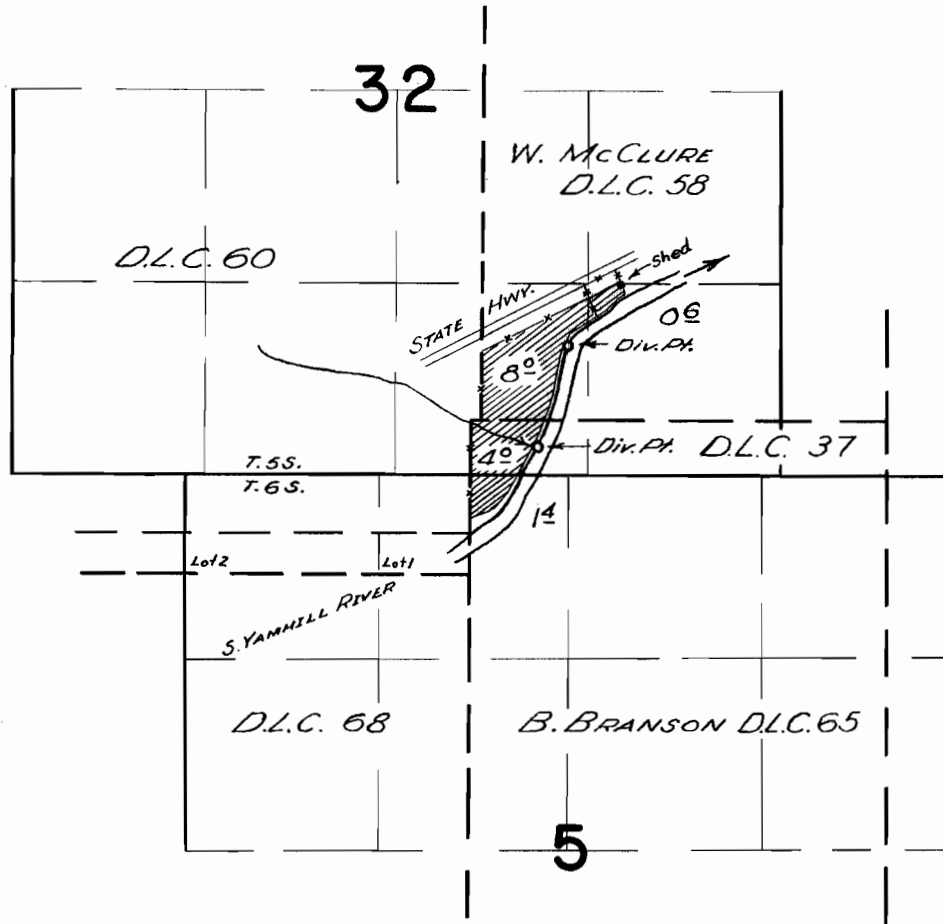

FINAL PROOF SURVEY UNDER

Application No. 33332 Permit No. 26362
IN NAME OF

J. W. HAMMONS

Surveyed MAY 14 1963, by m. Bish