


T. 3 S. R. 2 W. W.M.

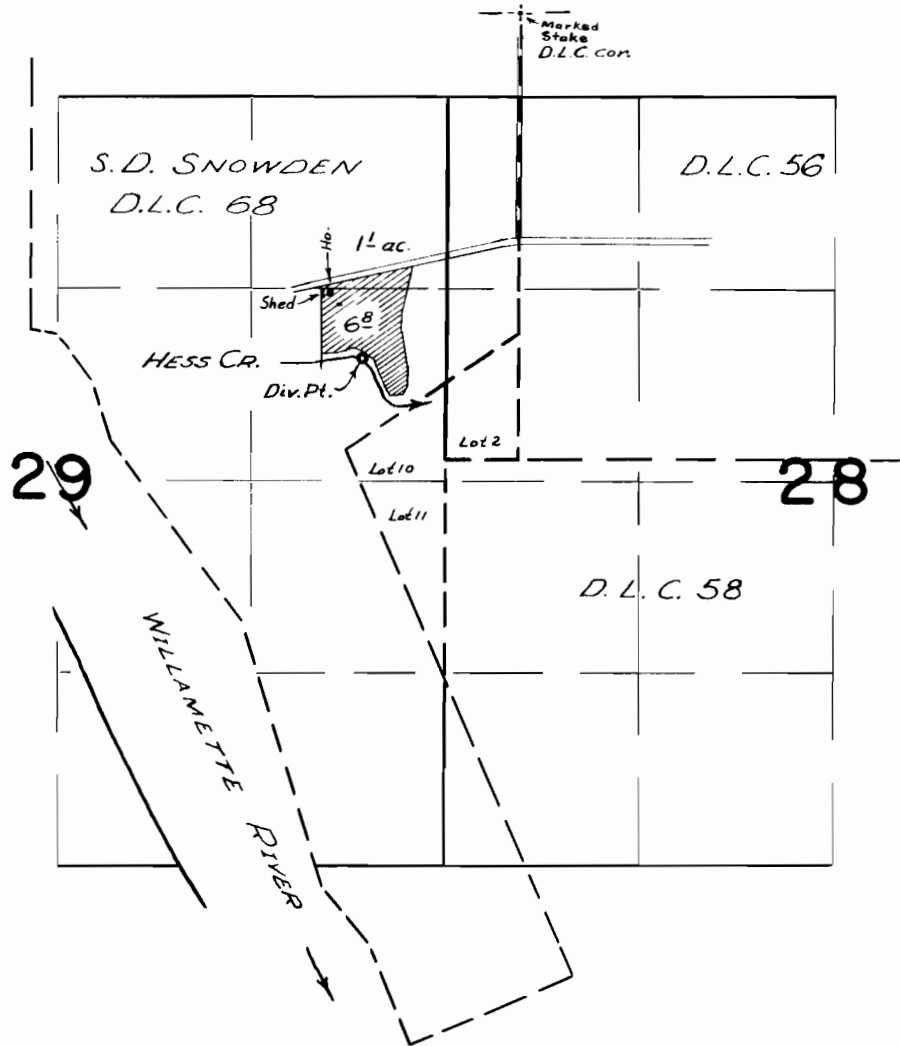

FINAL PROOF SURVEY UNDER

Application No. 34320 Permit No. 26984
IN NAME OF

CLAYTON G. & MARY JANE CATE

Surveyed April 9 1963, by m. Bish