


T. 5 S. R. 6 W. W.M.

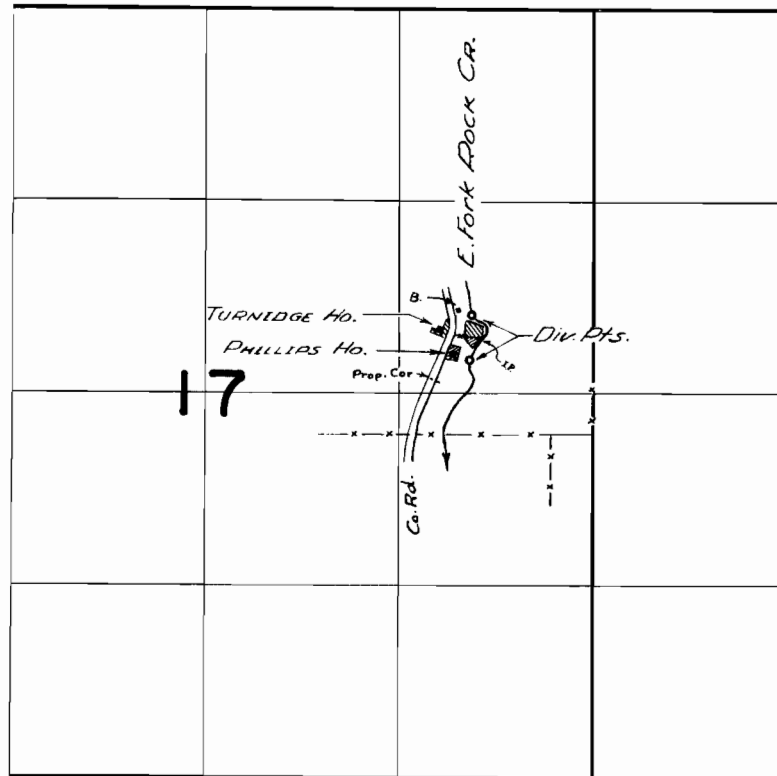

TURNIDGE



PHILLIPS



FINAL PROOF SURVEY
UNDER

Application No. 34354 Permit No. 27013
IN NAME OF

CECIL M. PHILLIPS & LESTER TURNIDGE

Surveyed MAY 15 1963, by Wm. B. Bish