


T. 4 S. R. 4 W. W.M.

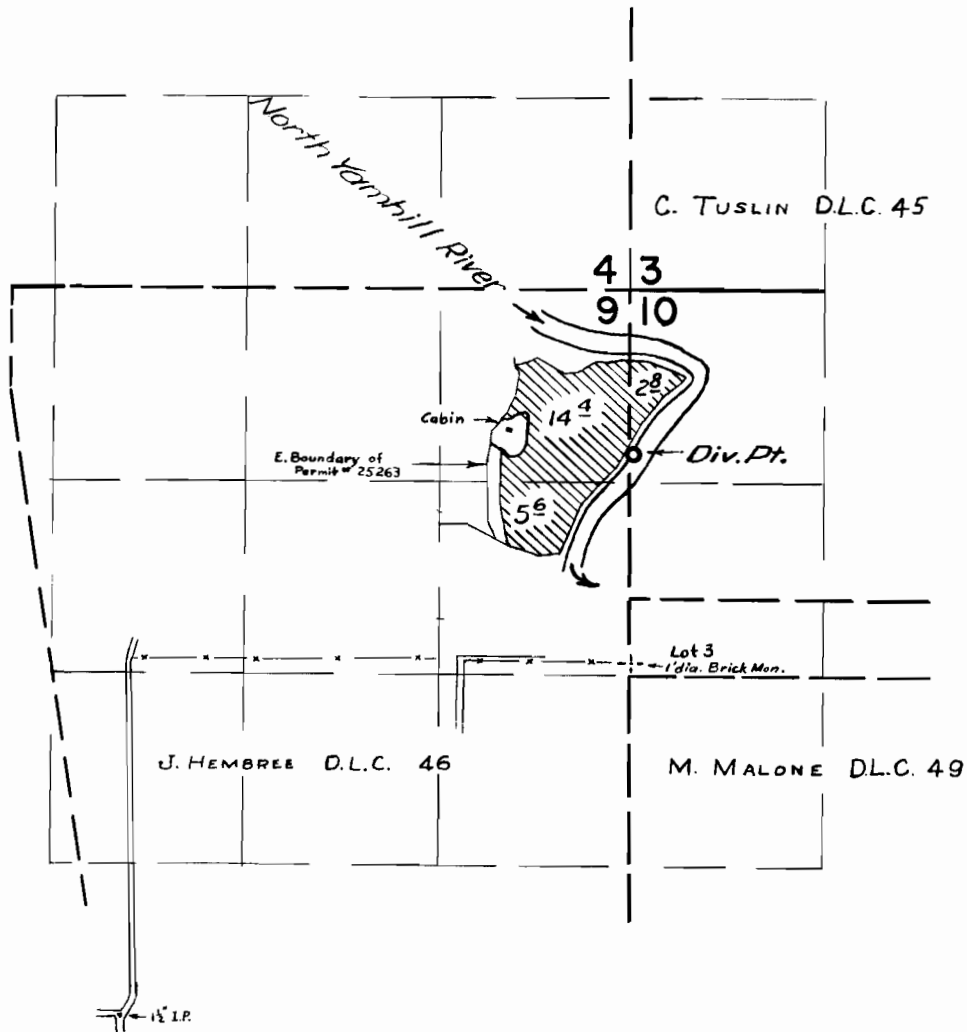

FINAL PROOF SURVEY UNDER

Application No. 34659 Permit No. 27223
IN NAME OF

HERBERT C. COLEMAN

Surveyed MAY 9 1963 by M. BISH
AUG. 27 1962, by R. JACKSON