


T. 5 S. R. 4 W. W. M.

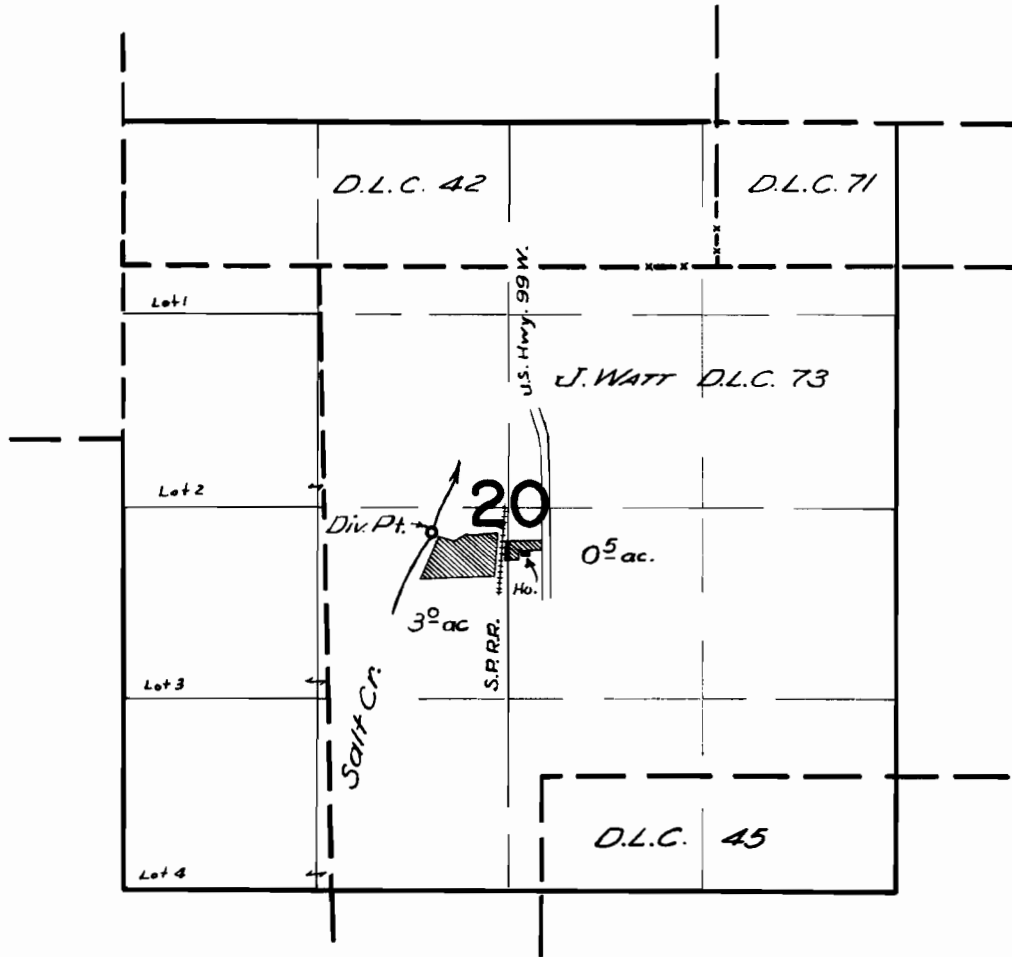

FINAL PROOF SURVEY UNDER

Application No. 34847 Permit No. 27355
IN NAME OF

LESLIE BUFFINGTON

Surveyed MAY 14 1963, by m. Bish