


T.38&4 S. R.2 W. W.M.

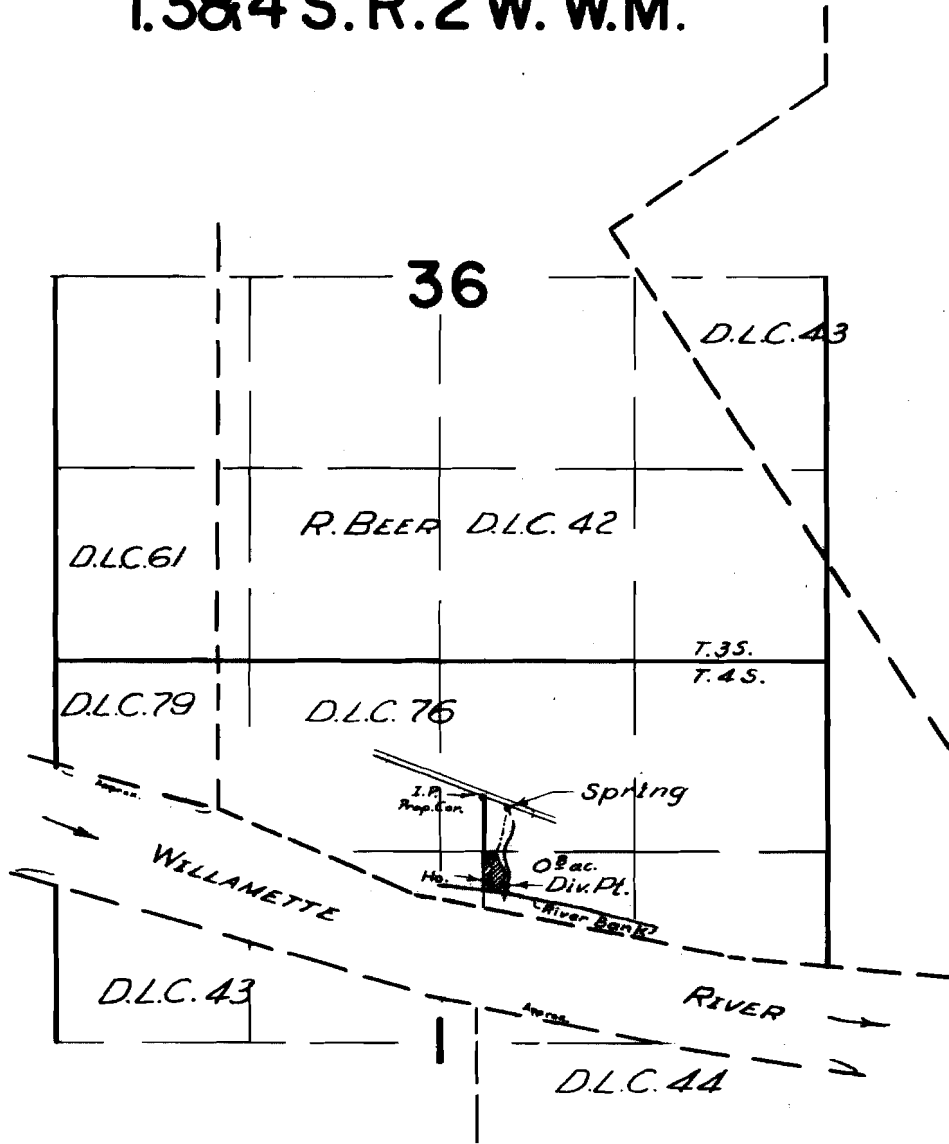

FINAL PROOF SURVEY
UNDER

Application No. 37708 Permit No. 28093
IN NAME OF

LOUIS & ALICE YOUNGBAR

Surveyed April 10, 1963, by m. Bish