


T.6 S. R. 6 W.W.M.

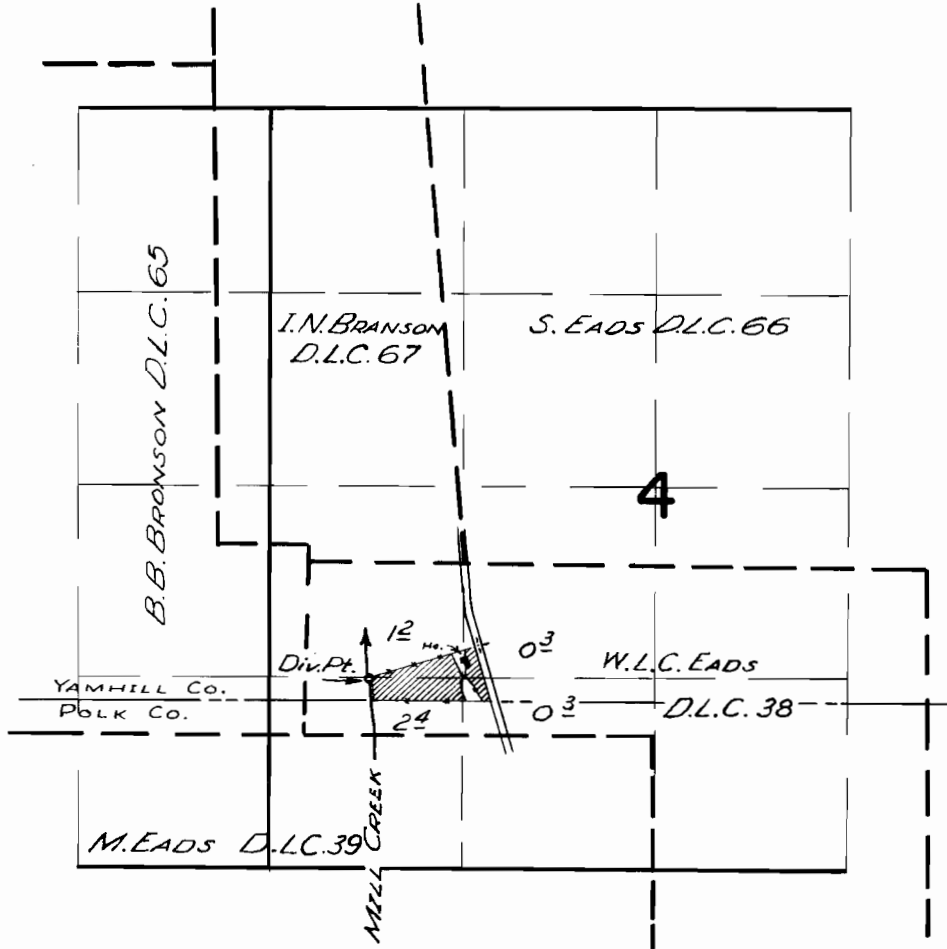

FINAL PROOF SURVEY UNDER

Application No. 37942 Permit No. 28369
IN NAME OF

EARL R. NEAL

Surveyed MAY 15, 1963, by m. Bish