


T. 10 S. R. 6 W. W. M.

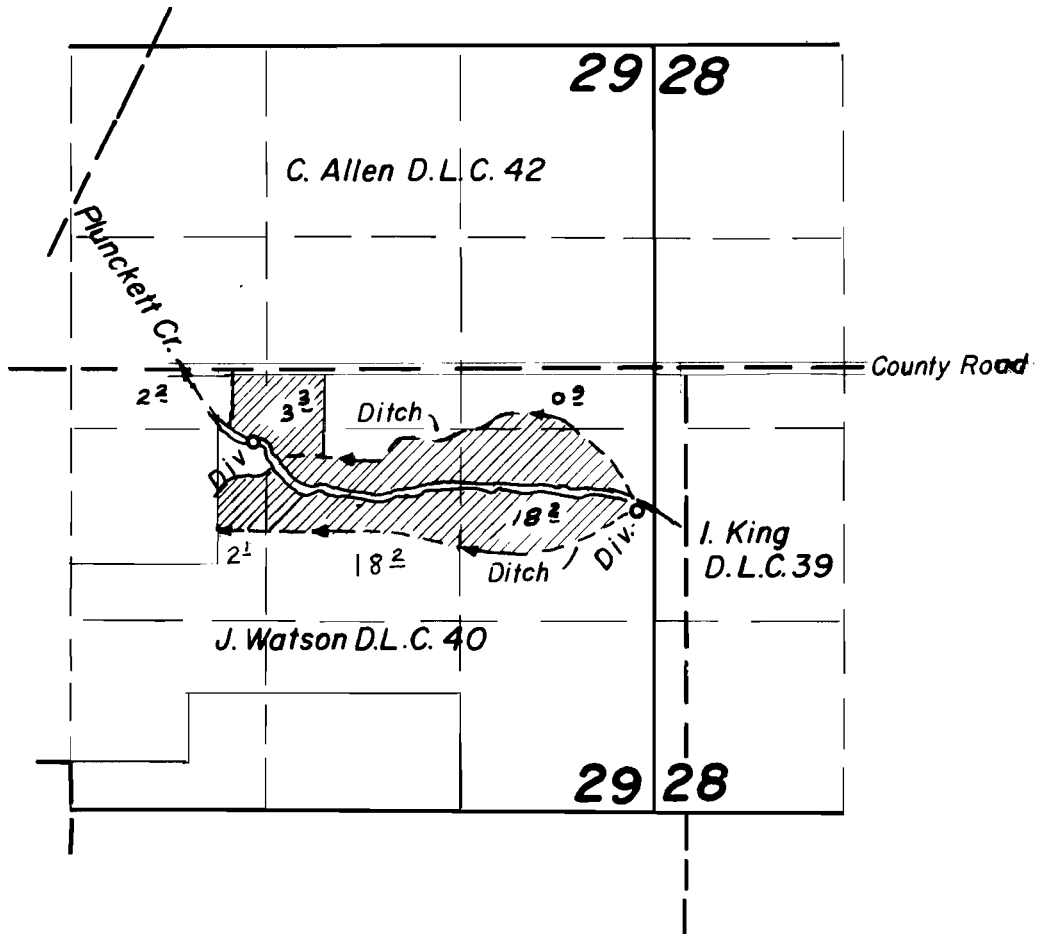

FINAL PROOF SURVEY
UNDER

Application No. 34055 Permit No. 26874
IN NAME OF

Jas. L. Price Estate

Surveyed Aug. 12 1964, by *Floyd L. Sigmund*