


T.10S.R.4W.W.M.

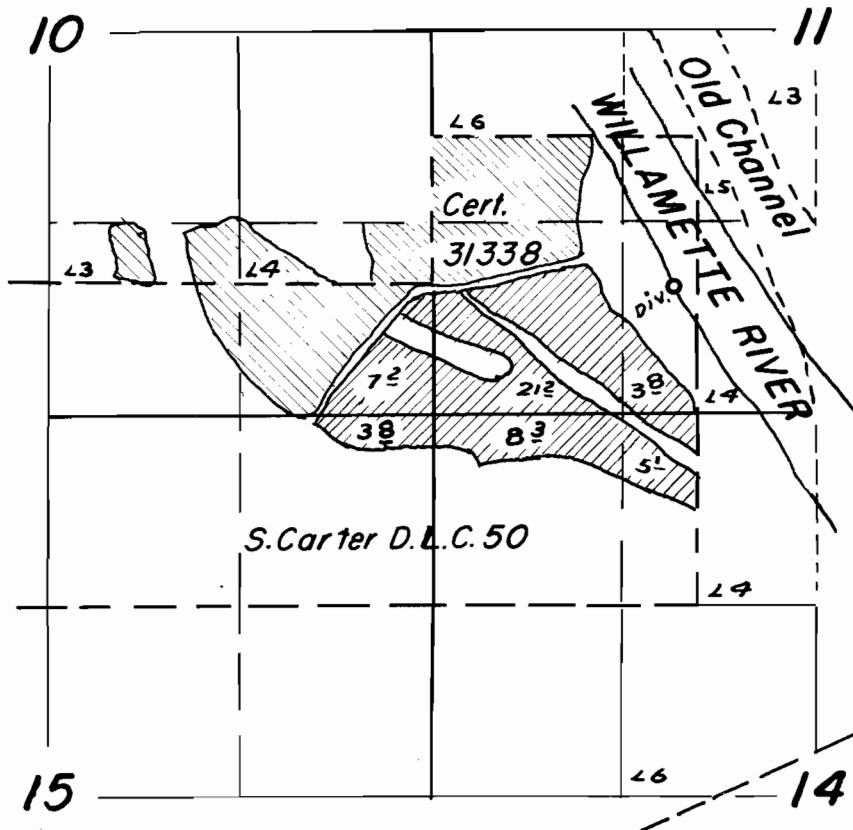

FINAL PROOF SURVEY
UNDER

Application No. 34546 Permit No. 27126
IN NAME OF

Kenneth Holmes

Surveyed July 17, 1964, by Glova L. Siegmund