


T.12 S.R.5 W.W.M.

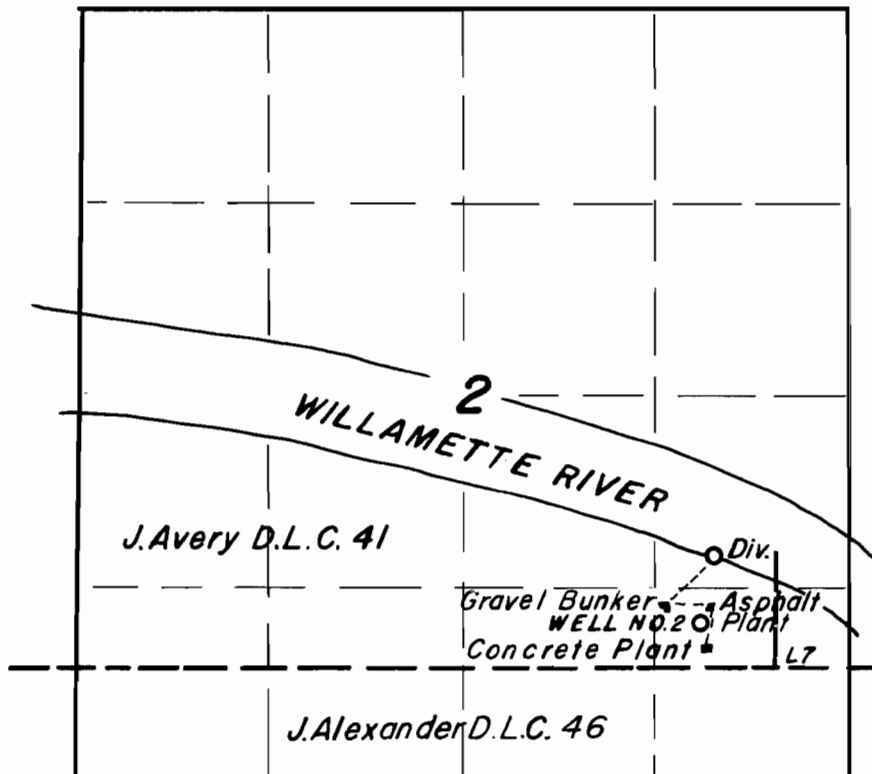

**FINAL PROOF SURVEY**  
UNDER

37461                      28169  
Application No. *G-2253* Permit No. *G-2250*  
IN NAME OF

***Corvallis Sand & Gravel Company***

Surveyed *Mar. 23* 1965, by *F. Siegmund*.