


T.3S.R.2E.W.M.

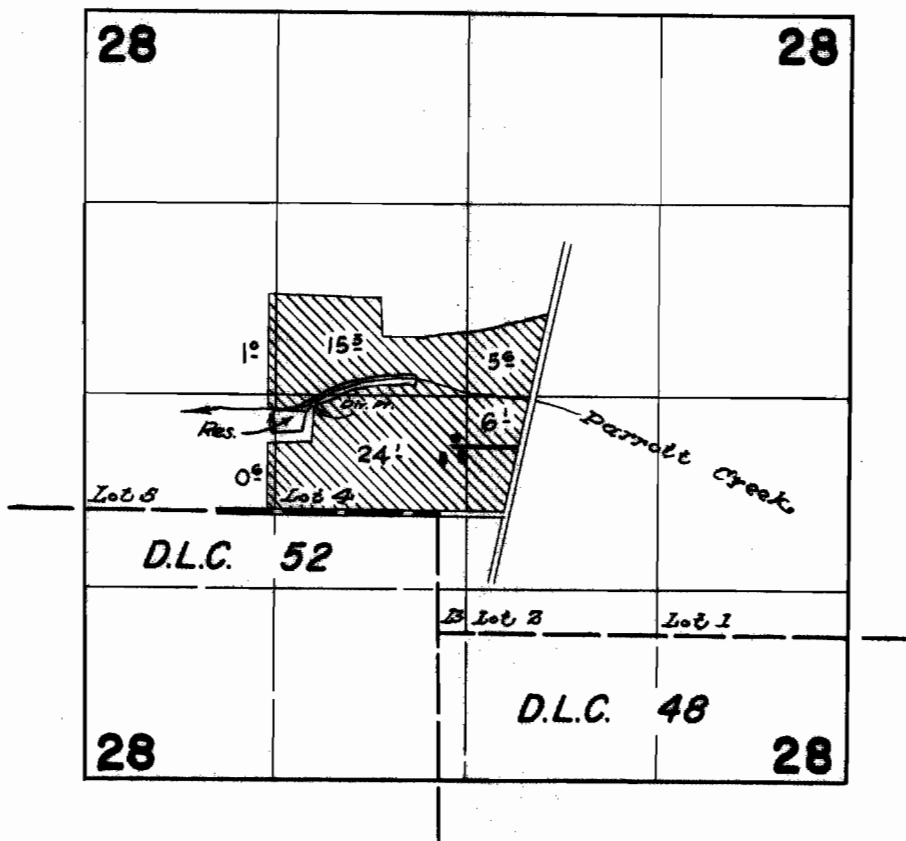

FINAL PROOF SURVEY UNDER

R-34360 R-2464
 Application No. 34361 Permit No. 26922
 IN NAME OF

ELDON EVANS

Surveyed April 22 1963, by *[Signature]*