


# T.3S.R.2E.W.M.

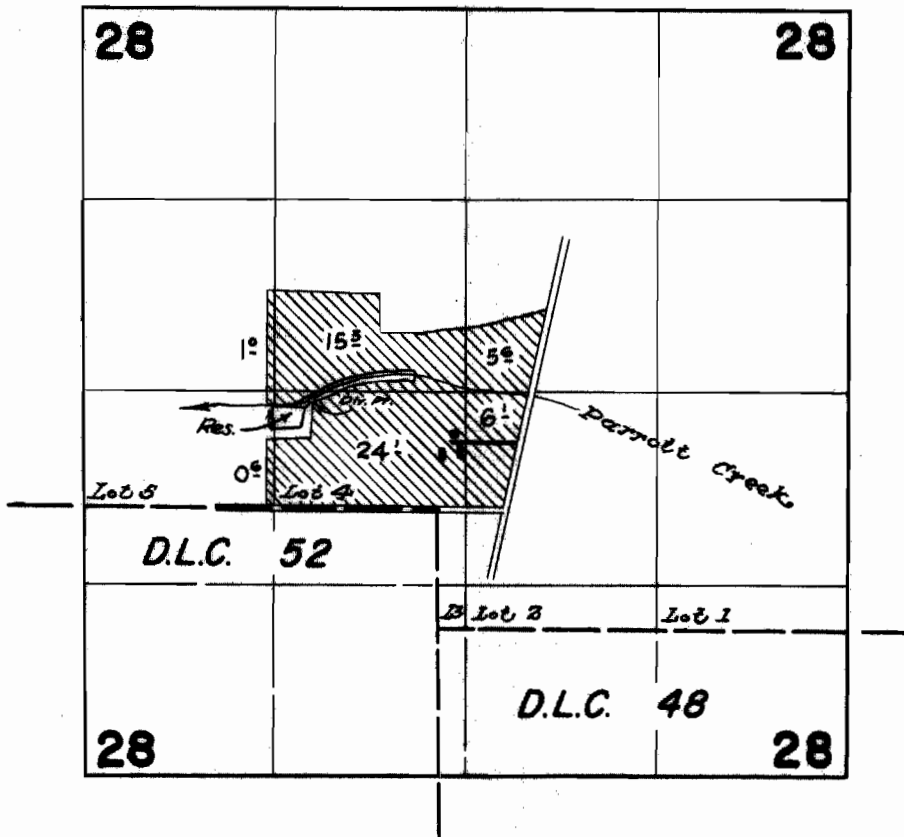

## FINAL PROOF SURVEY UNDER

R-34360                      R-2464  
Application No. 34361      Permit No. 26922  
IN NAME OF

ELDON EVANS

Surveyed April 22 1963, by