


T.6N.R.2W.W.M.

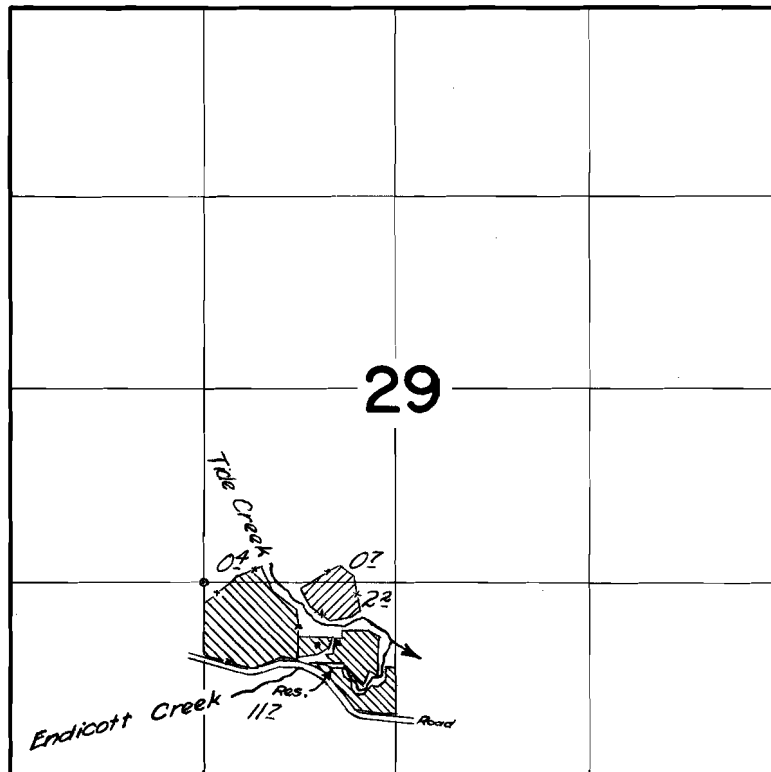

FINAL PROOF SURVEY
UNDER

Application No. R-28135 Permit No. R-1519
28136 22434
IN NAME OF

ENDICOTT CREEK FARMS

Surveyed July 17, 1962, by L. Jackson