


T.29S.R.14W.W.M.

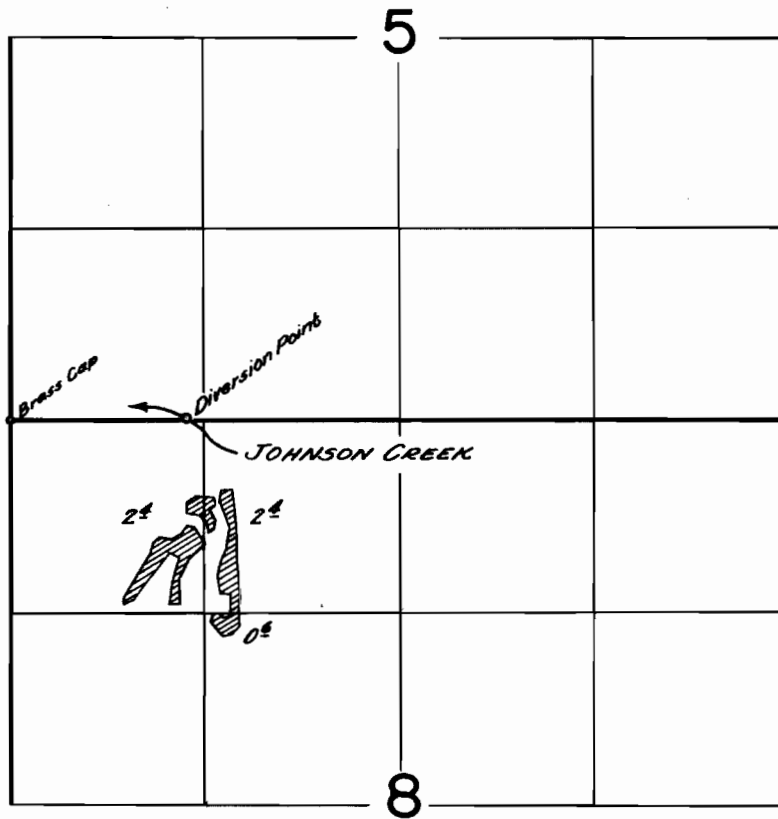

**FINAL PROOF SURVEY**  
UNDER

Application No. 33236. Permit No. 26282..  
IN NAME OF

.....**Elmer A. or Grace E. Gant**.....

Surveyed Aug. 14. 1963, by T. Lauer.....