


T.28S.R.7W.W.M.

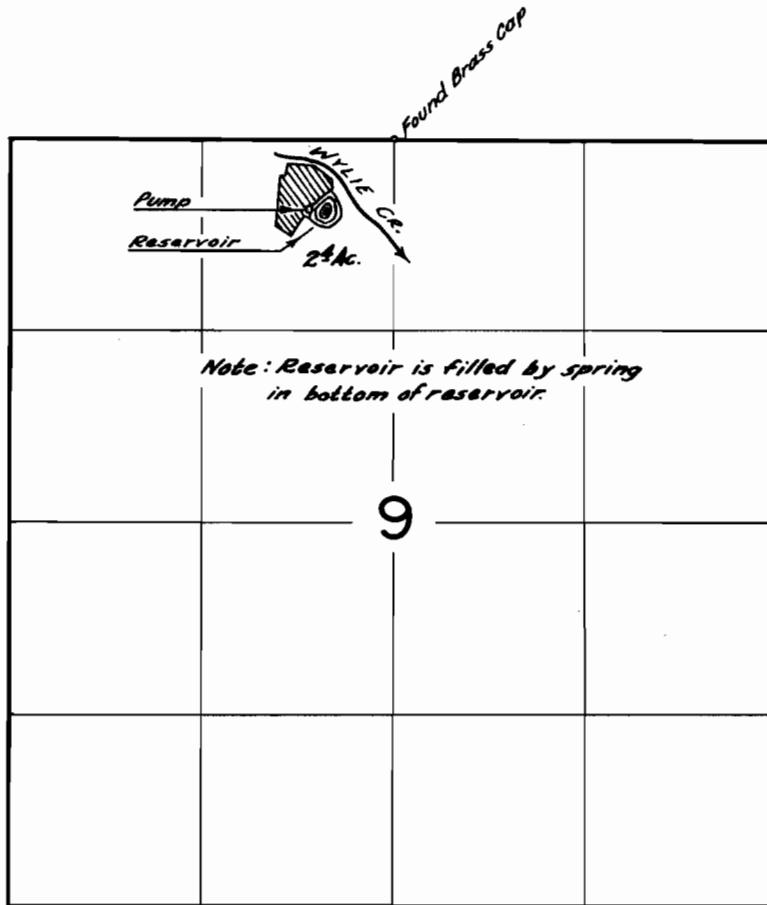

**FINAL PROOF SURVEY**  
UNDER

Application No. R-33202 33238 Permit No. R-2263 26283  
IN NAME OF

R. E. Wylie

Surveyed May 14 1963, by T. Lauer