


T.30S.R.9W.W.M.

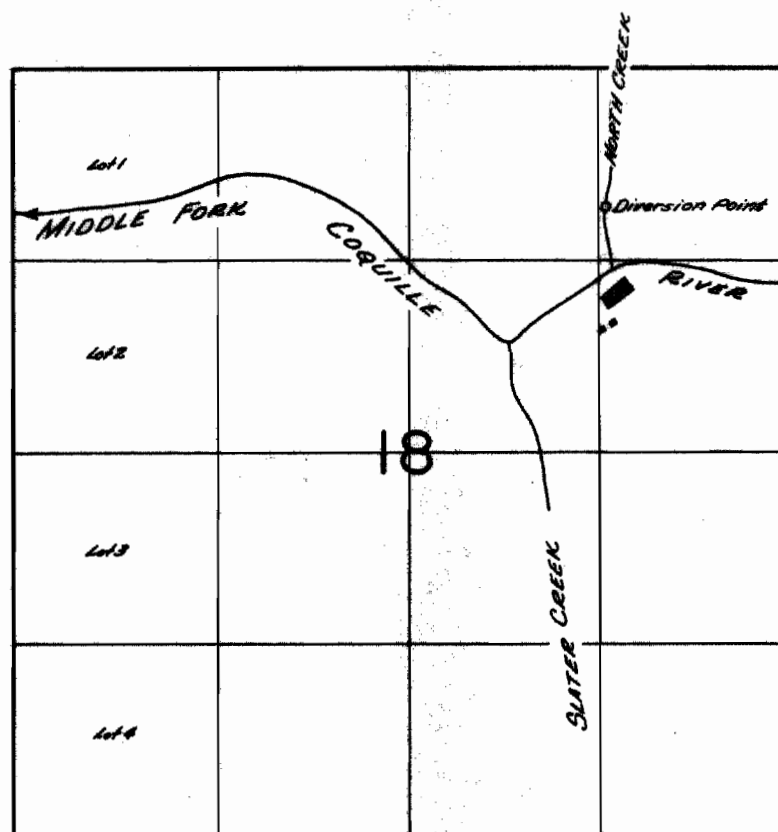

FINAL PROOF SURVEY
UNDER

Application No. 37074 Permit No. 27651
IN NAME OF

Maynard G. & Gerald L. Looney

Surveyed June 7, 1963, by T. Lauer