


T. 27S.R. 4W.W.M.

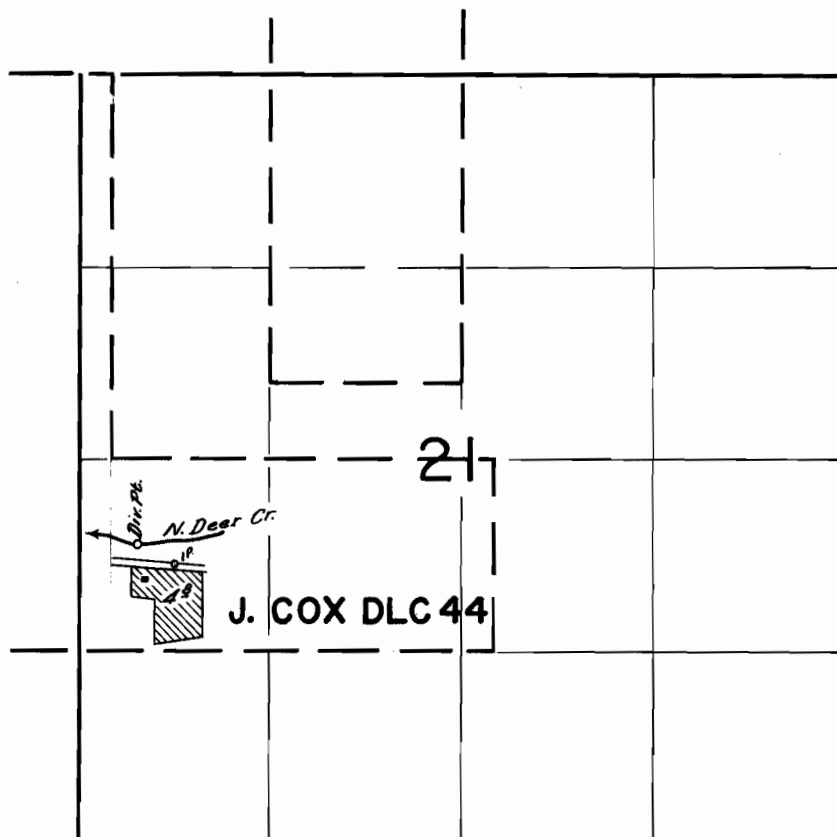

FINAL PROOF SURVEY
UNDER

Application No. 37863 Permit No. 28220
IN NAME OF

Linard & Audry Starnes

Surveyed May 18 1963, by T. Lauer