


T.27S.R.4W.W.M

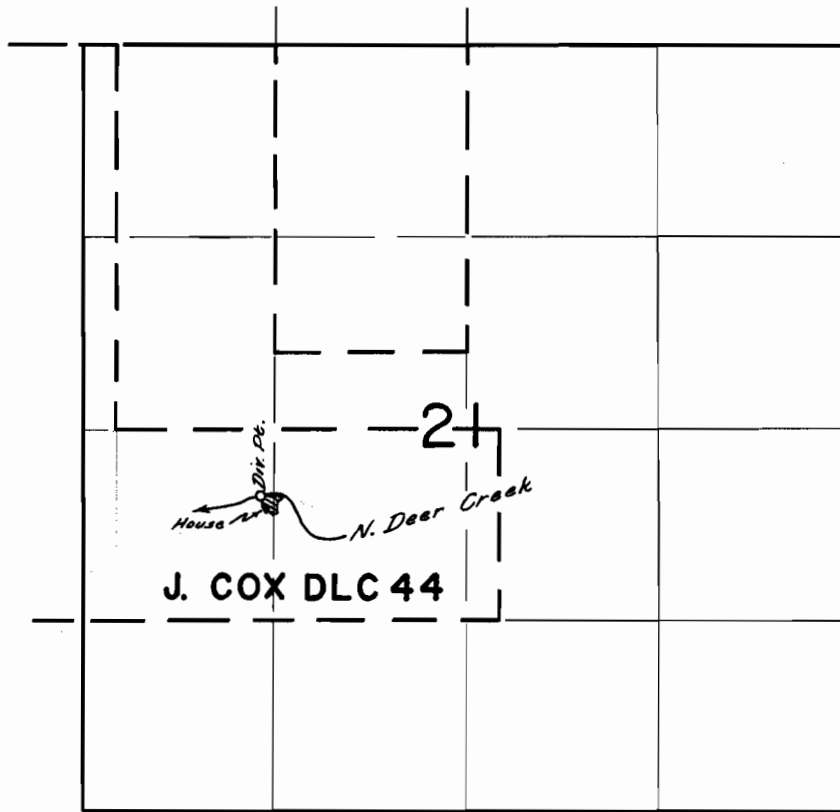

FINAL PROOF SURVEY
UNDER

Application No. 37955.. Permit No. 28306...
IN NAME OF

..... **Walter M. Reid**

Surveyed May 18... 1963, by T. Lauer.....