


T. 28 S. R. 6 W. W.M.

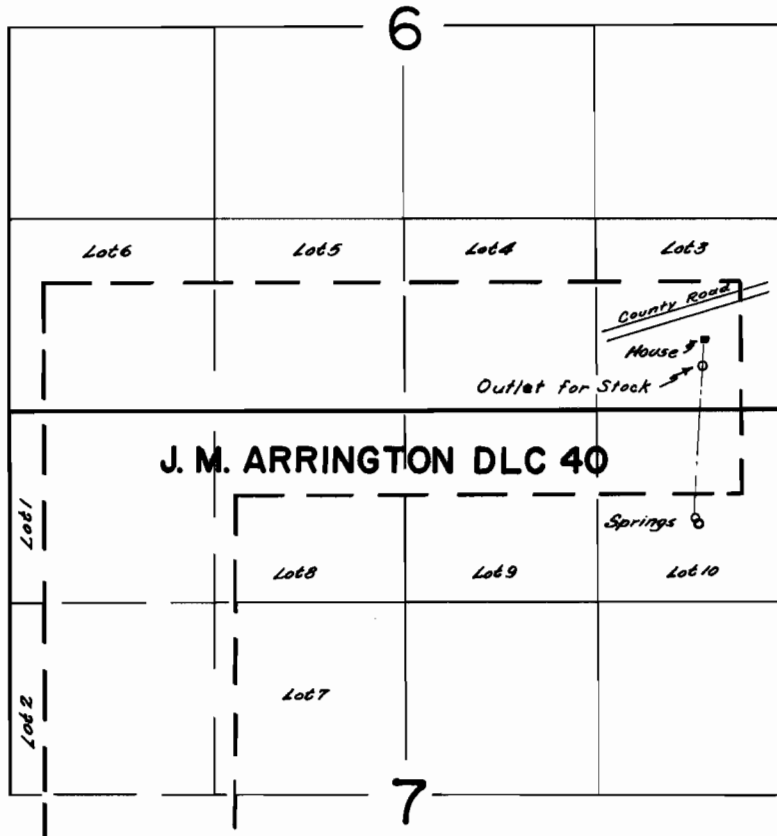

**FINAL PROOF SURVEY**  
UNDER

Application No. 37865 Permit No. 28362  
IN NAME OF

Rodney D. Trotter

Surveyed May 14 1963, by T. Lauer