


T.27S.R.4W.W.M.

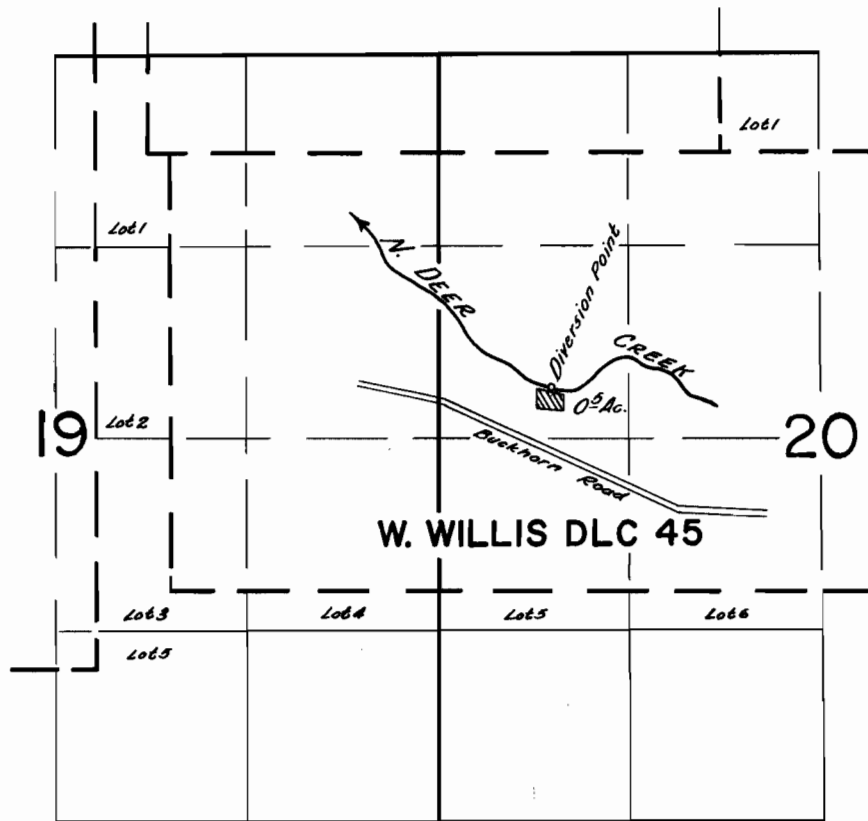

FINAL PROOF SURVEY
UNDER

Application No. 37890 Permit No. 28427
IN NAME OF

Chester G. Campbell

Surveyed May 18 1963, by T. Lauer