


T.24S.R.32E.W.M.

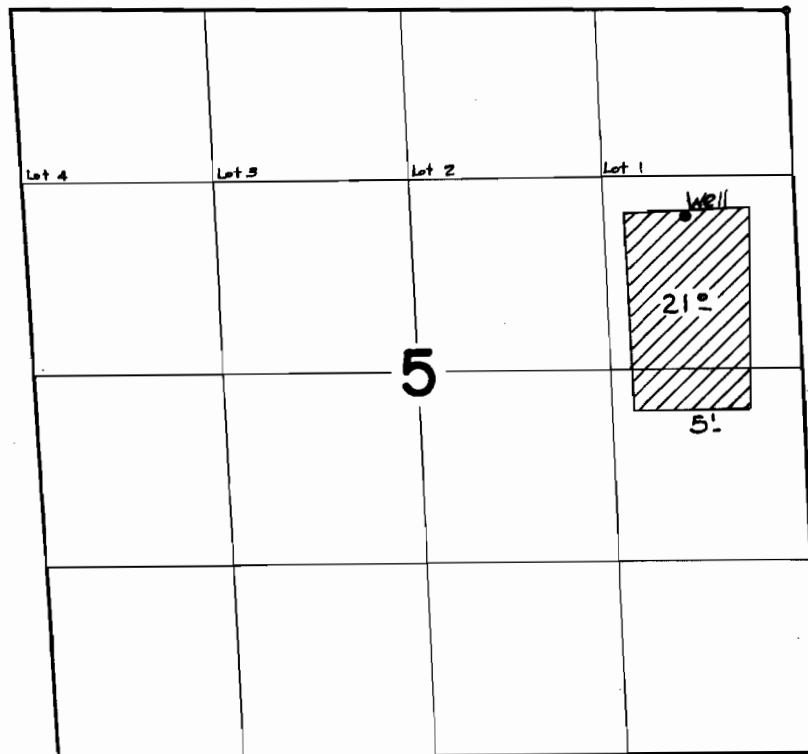

FINAL PROOF SURVEY
UNDER

Application No. G-364 Permit No. G-388
IN NAME OF

JOHN WOOD

Surveyed SEPT. 12, 1964, by C. R. BAKER