


T.23 S.R.31E.W.M.

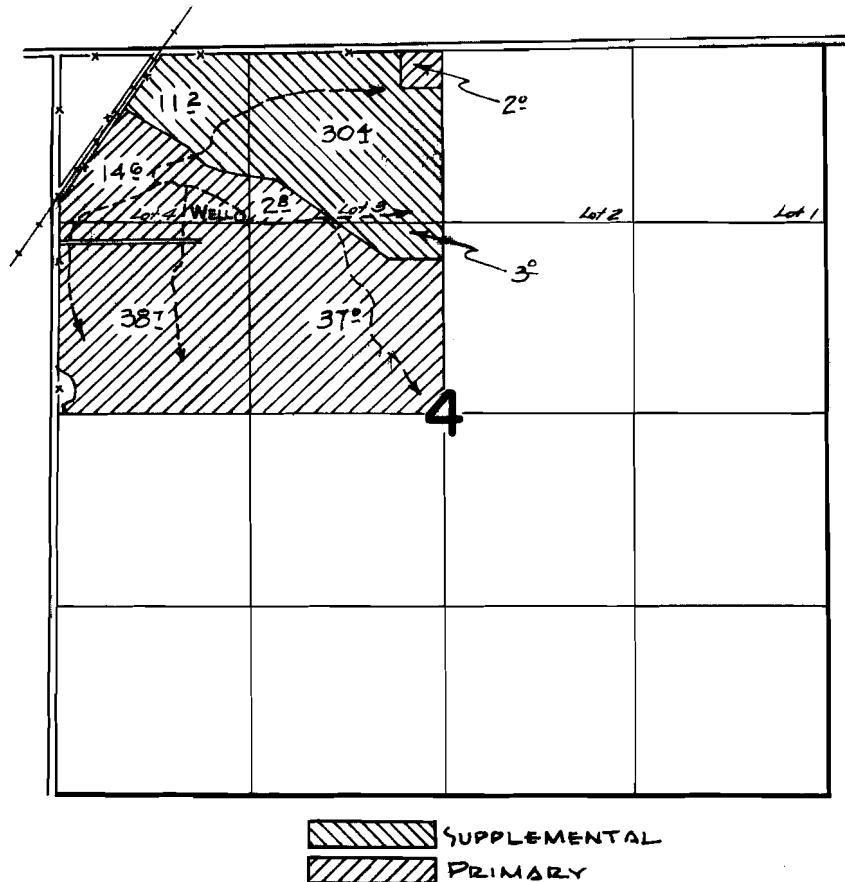

FINAL PROOF SURVEY
UNDER

Application No. G-1977 Permit No. G-1813.
IN NAME OF

LESTER TYLER

Surveyed Sept. 14 1963, by C. R. BAKER