


T.37S.R.1W.W.M.

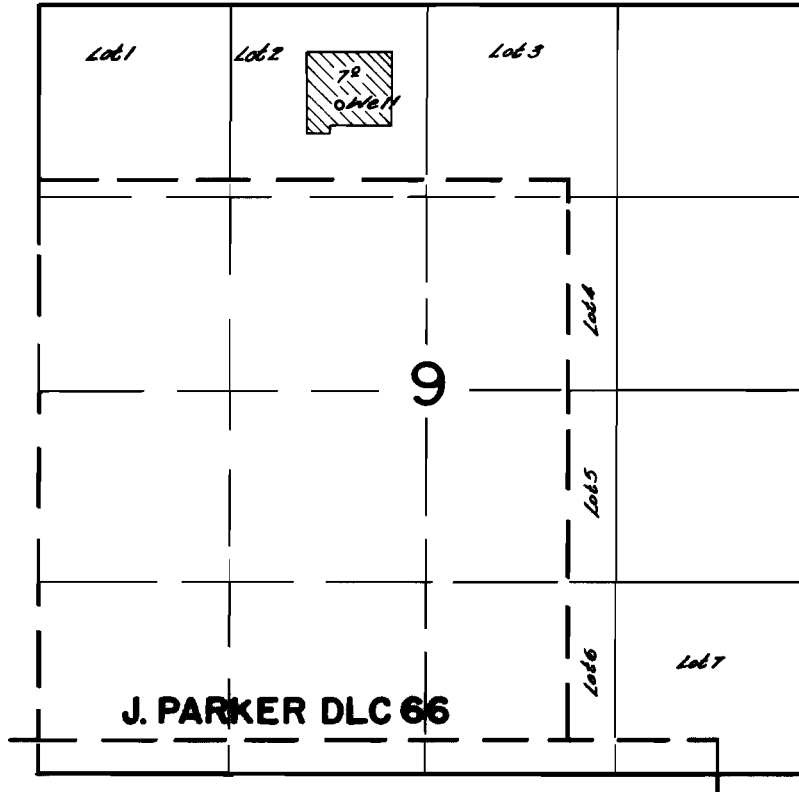

**FINAL PROOF SURVEY**  
UNDER

Application No. G-1227 Permit No. G-1071.....  
IN NAME OF

.....**Elbert Darius Davis**.....

Surveyed June 13, 1963, by C. Baker.....