


T. 37 S. R. 2 W. W. M.

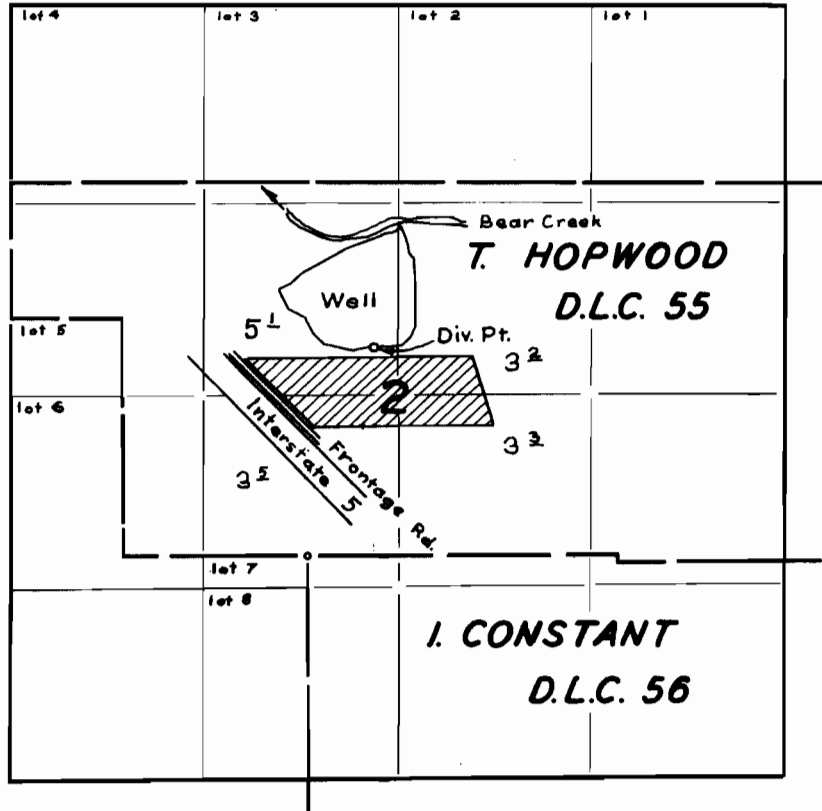

FINAL PROOF SURVEY
UNDER

Application No. G-1760..... Permit No. G-1614.....
IN NAME OF

KENNETH W. AND KENNETH R. BEEBE

Surveyed MAY 14..... 19.63, by R. JACKSON.....