


T.34S.R.3E.W.M.

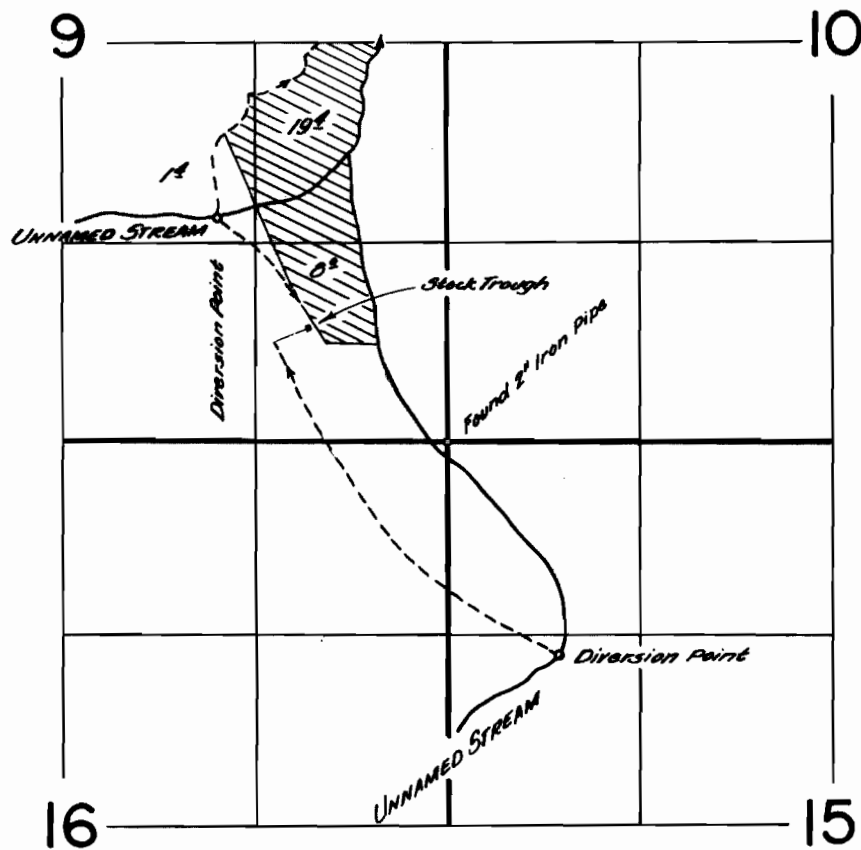

FINAL PROOF SURVEY
UNDER

Application No. 31115 Permit No. 24487
IN NAME OF

Curtis Thomson

Surveyed June 12, 1963, by C. Baker