


T.35S.R.3W.W.M.

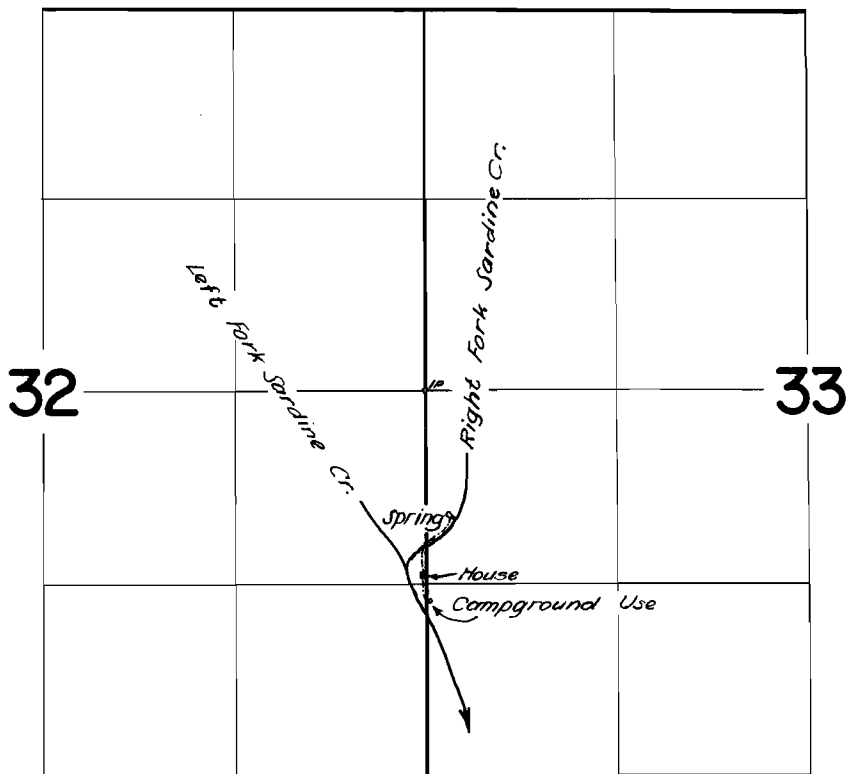

**FINAL PROOF SURVEY**  
UNDER

Application No. 31485... Permit No. 24820...  
IN NAME OF

William Dovichi

Surveyed May 22, 1963, by