


T. 37S. R. 4W. W.M.

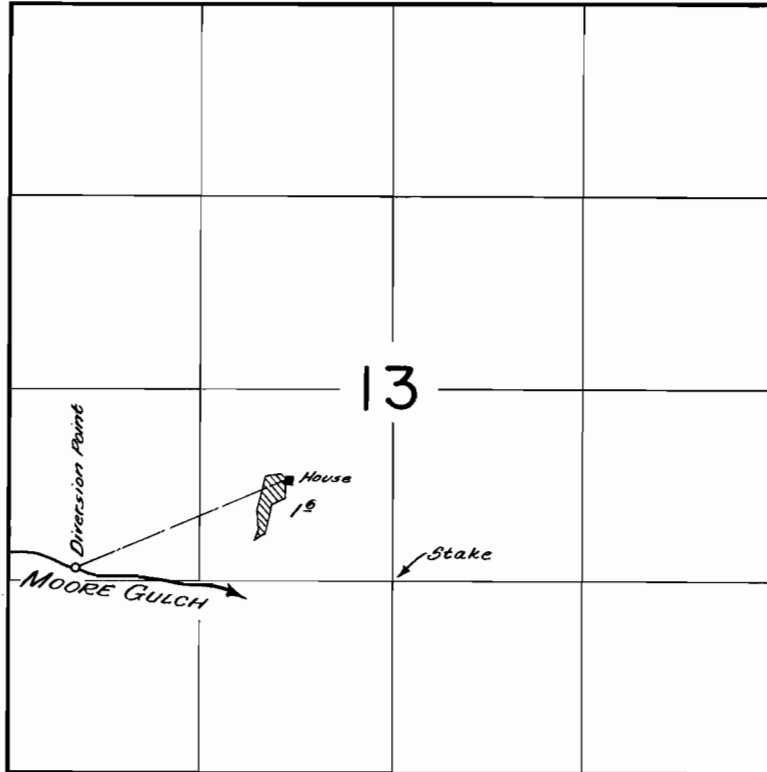

FINAL PROOF SURVEY
UNDER

Application No. 31530 Permit No. 24868
IN NAME OF

Maxwell L. and Marcia E. Thayer

Surveyed July 15, 1963, by C. Baker