


T.35S.R.2W.W.M.

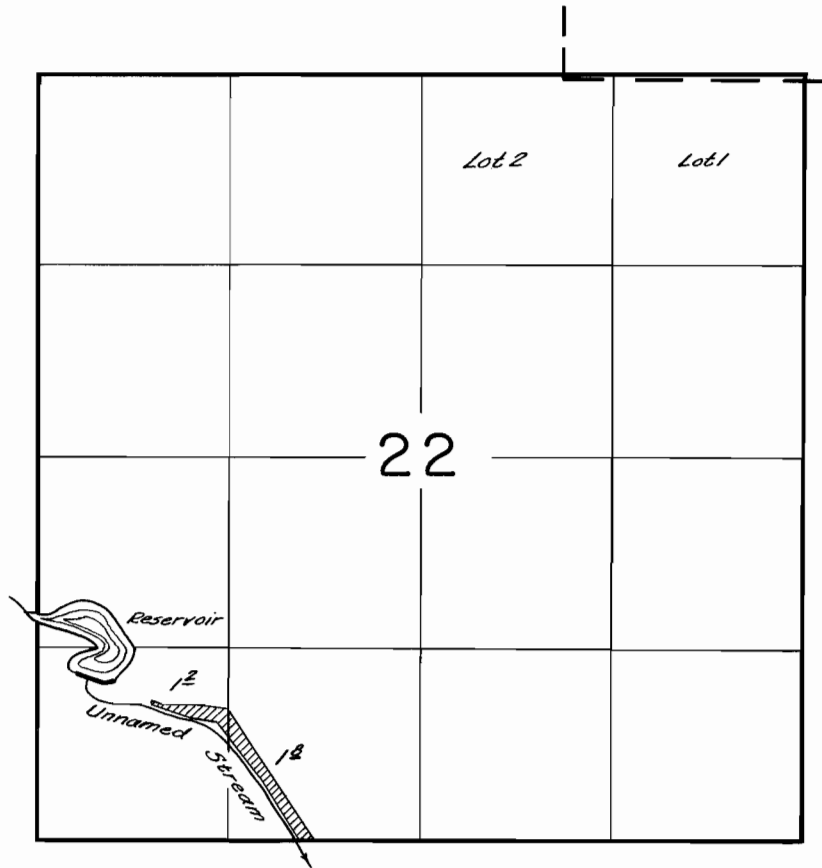

FINAL PROOF SURVEY
UNDER

Application No. R-31371 Permit No. R-2016
31372 24885
IN NAME OF

Earl Bigham

Surveyed June 10, 1963, by C. Baker