


T. 36S. R. 1W. W.M.

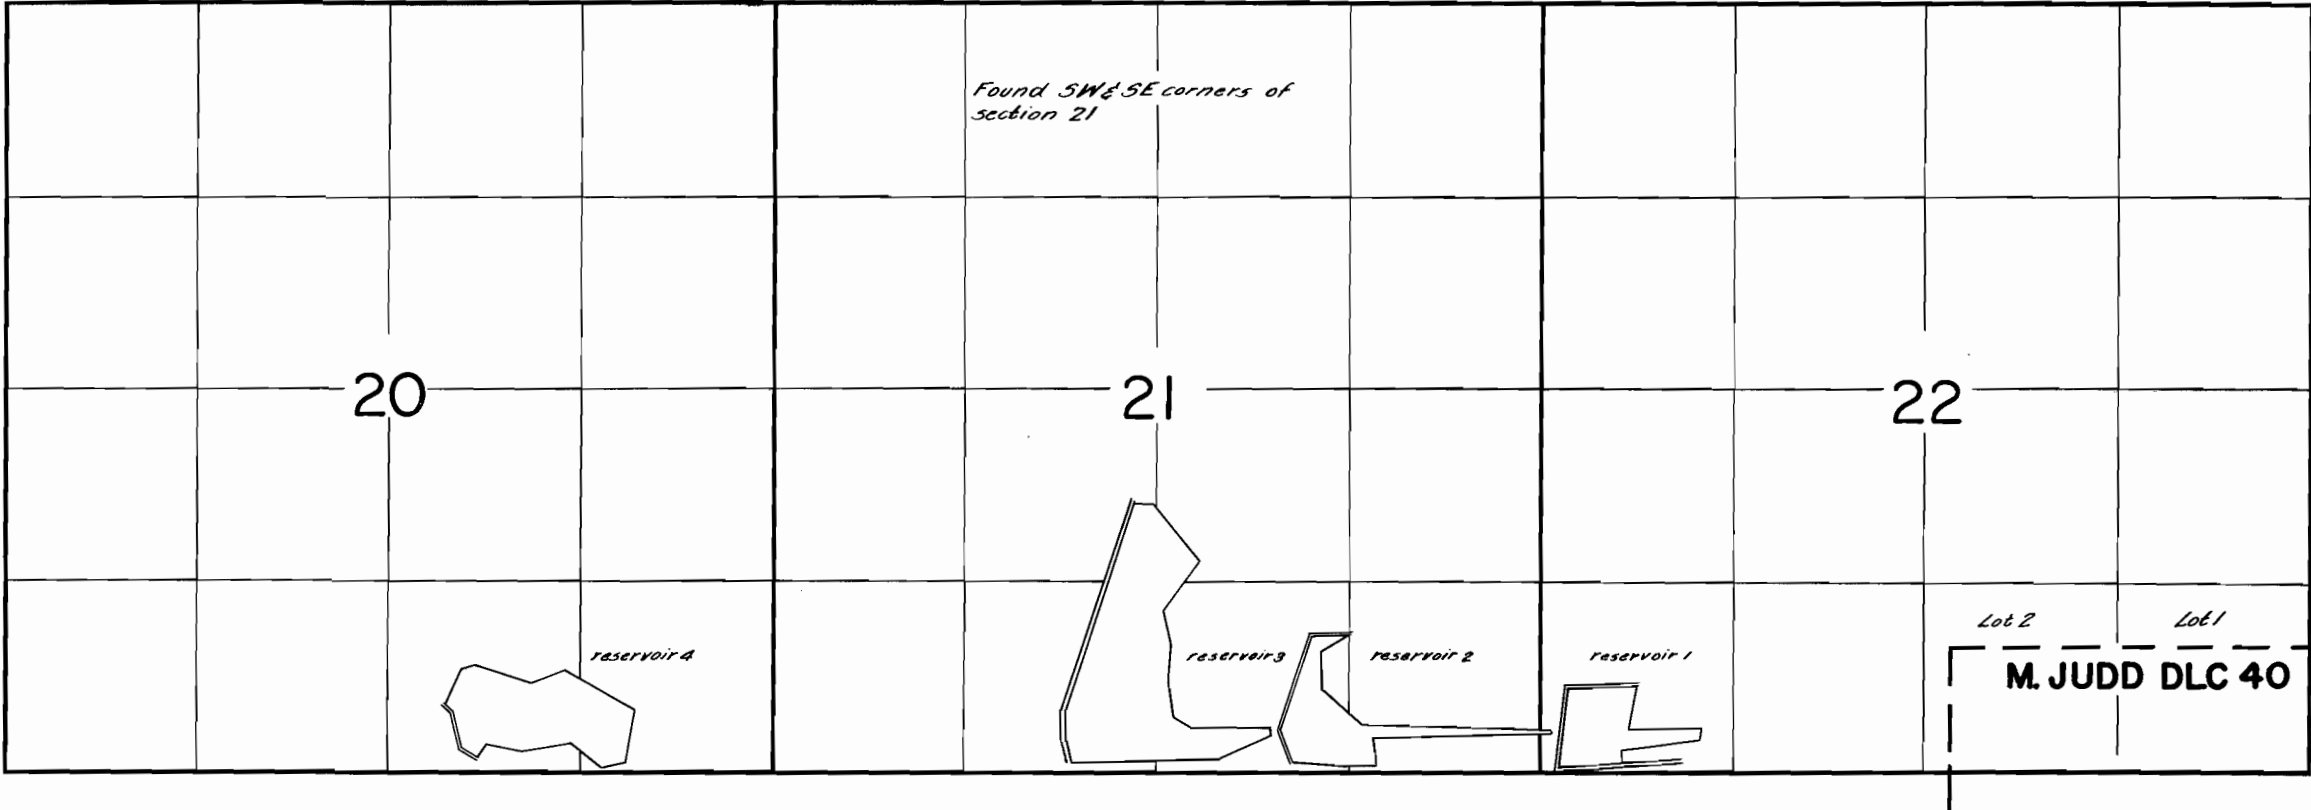

**FINAL PROOF SURVEY**

**Appl. No. 34606 Permit No. 27198**  
**R-34605 R-2588**

**MELVIN & ROSALIND HOOVER**

**Surveyed May 18, 1963 by C. Baker**