


# T. 40 S. R. 8 W.W.M.

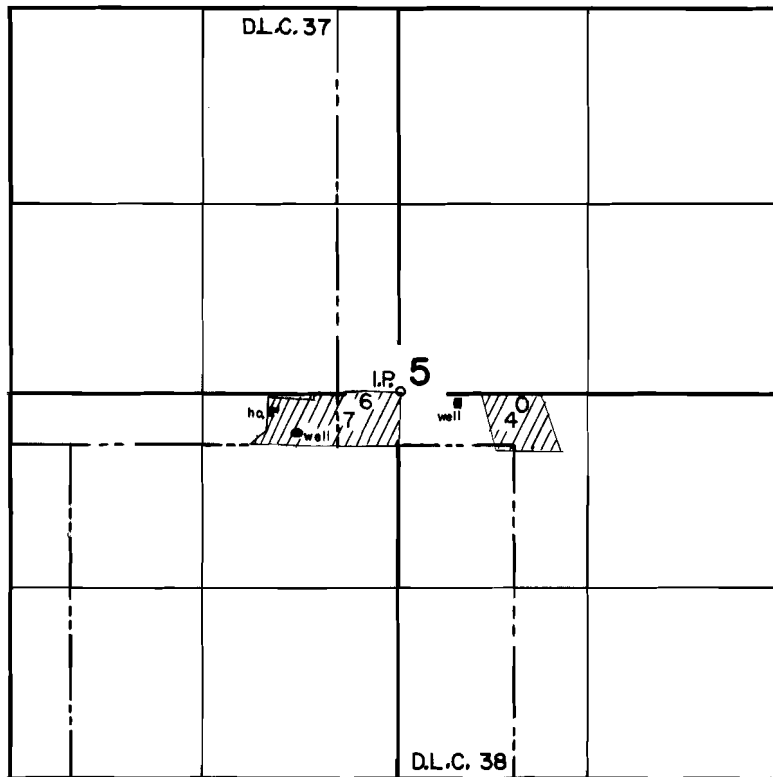

## FINAL PROOF SURVEY UNDER

Application No. G-1957 Permit No. G-1799  
IN NAME OF

Kenneth S. & Reba L. Franklin

Surveyed July 2 1964, by R.B. Steimer