


T. 35 S. R. 6 W.W.M.

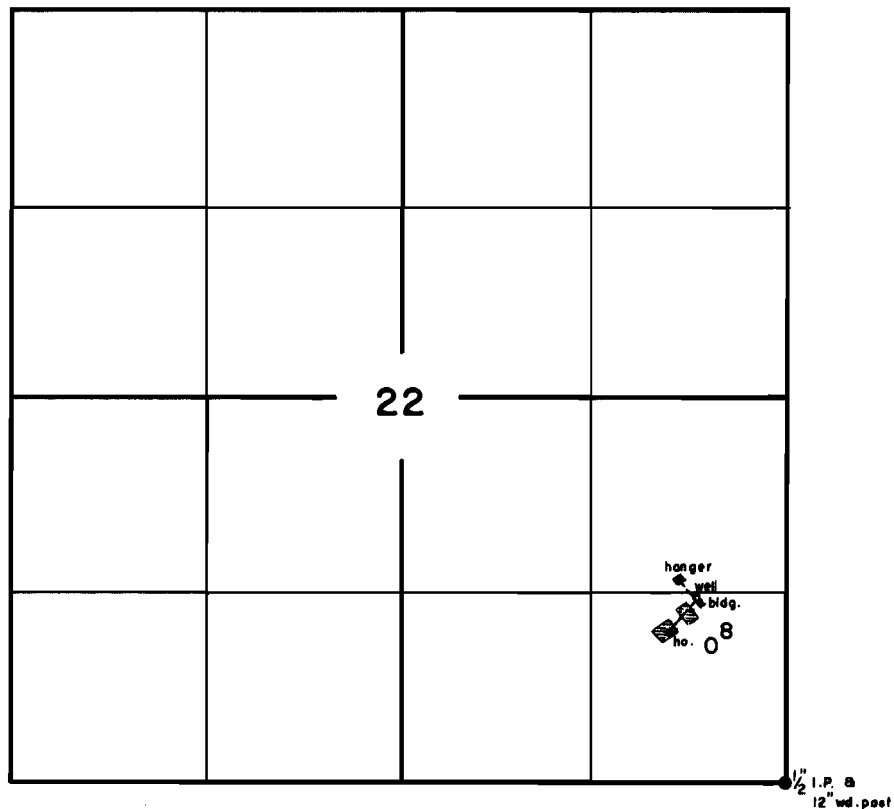

FINAL PROOF SURVEY
UNDER

Application No. G-2237 Permit No. G-2060
IN NAME OF

.....Josephine County (Airport).....

Surveyed Oct. 22, 1964, by R.B. Steimer.....