


T.38S.R.5W.W.M.

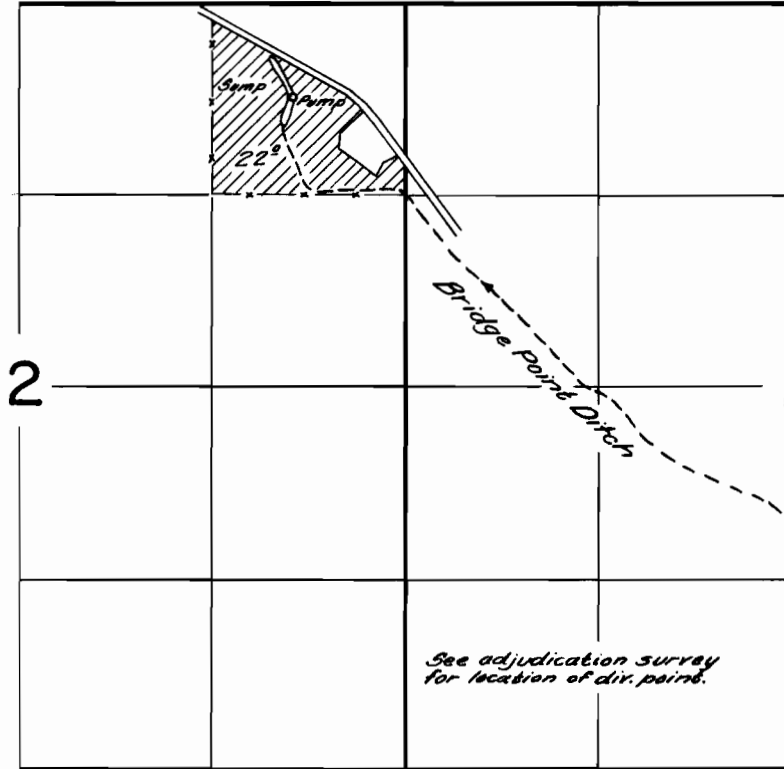

FINAL PROOF SURVEY
UNDER

Application No. 32765 Permit No. 25857
IN NAME OF

Mrs. A. Sakraida

Surveyed May 15 1963, by C. Baker