


T. 38 S. R. 8 W. W.M.

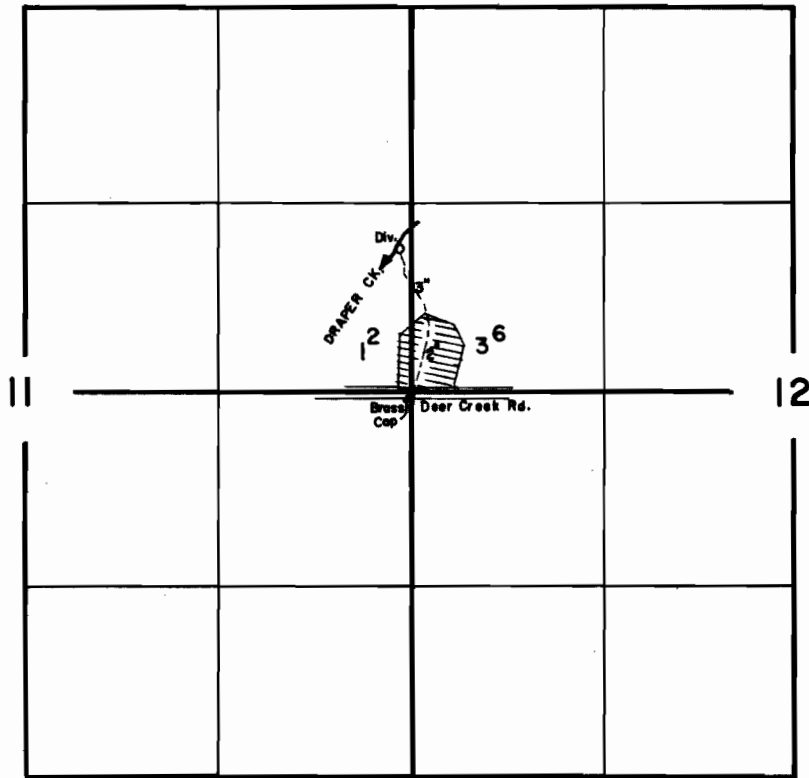

FINAL PROOF SURVEY
UNDER

Application No. 33896 Permit No. 26810
IN NAME OF

.....FRITZ KRAUSS.....

Surveyed JULY 7, 1964, by R.B. STEIMER