


T. 39 S. R. 8W.W.M.

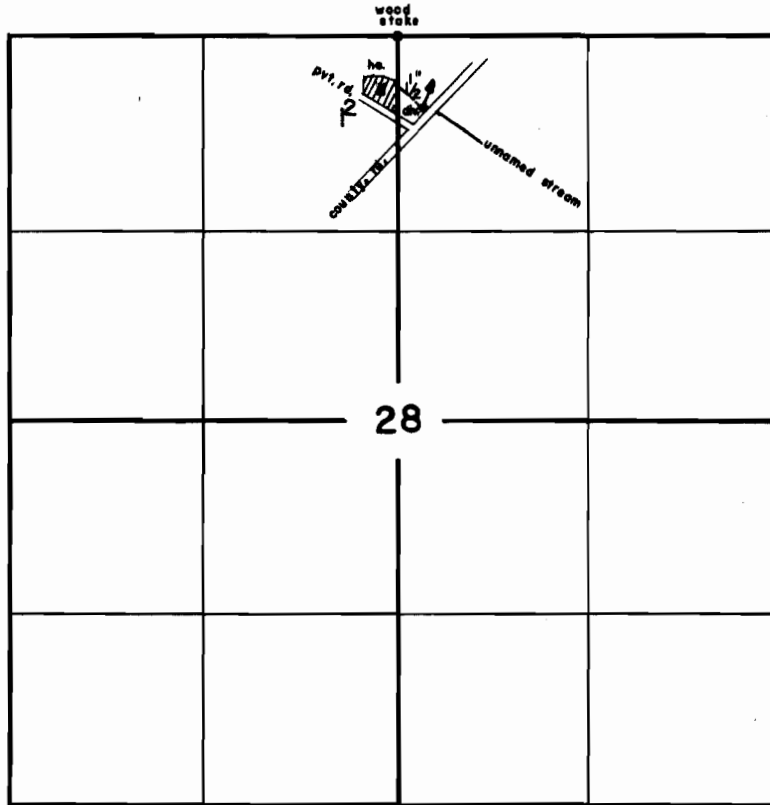

FINAL PROOF SURVEY
UNDER

Application No. 34662.. Permit No. 27253..
IN NAME OF

.....TED. RODGERS.....

Surveyed MAY...21.. 1964, by R.B.STEIMER..