


T. 39 S. R. 8 W.W.M.

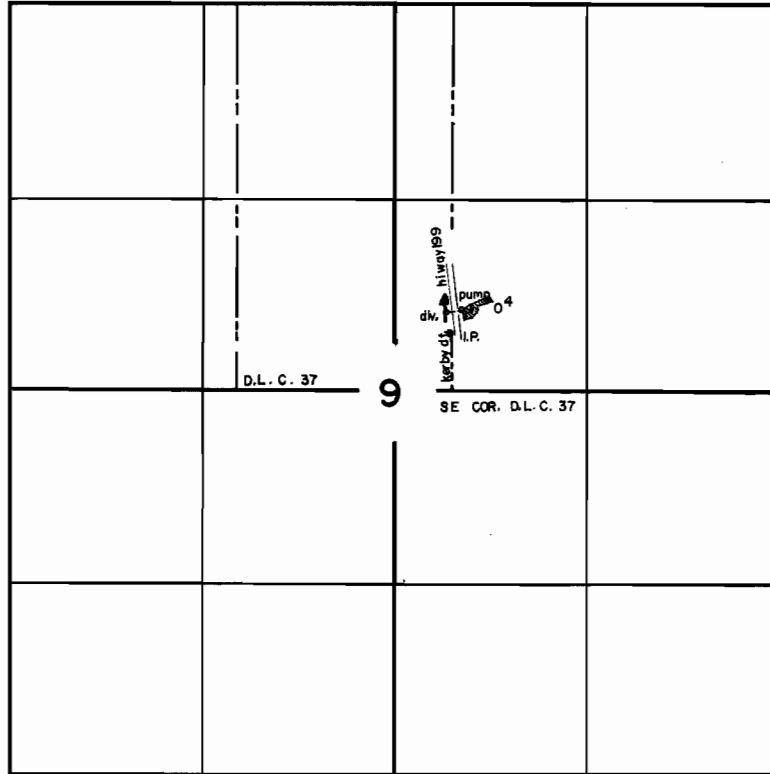

**FINAL PROOF SURVEY**  
UNDER

Application No. 37662 Permit No. 28072  
IN NAME OF

ARTHUR and JOY KELLERT

Surveyed MAY 21 1964, by R. B. STEIMER