


35

745' WELL

1045'

889'

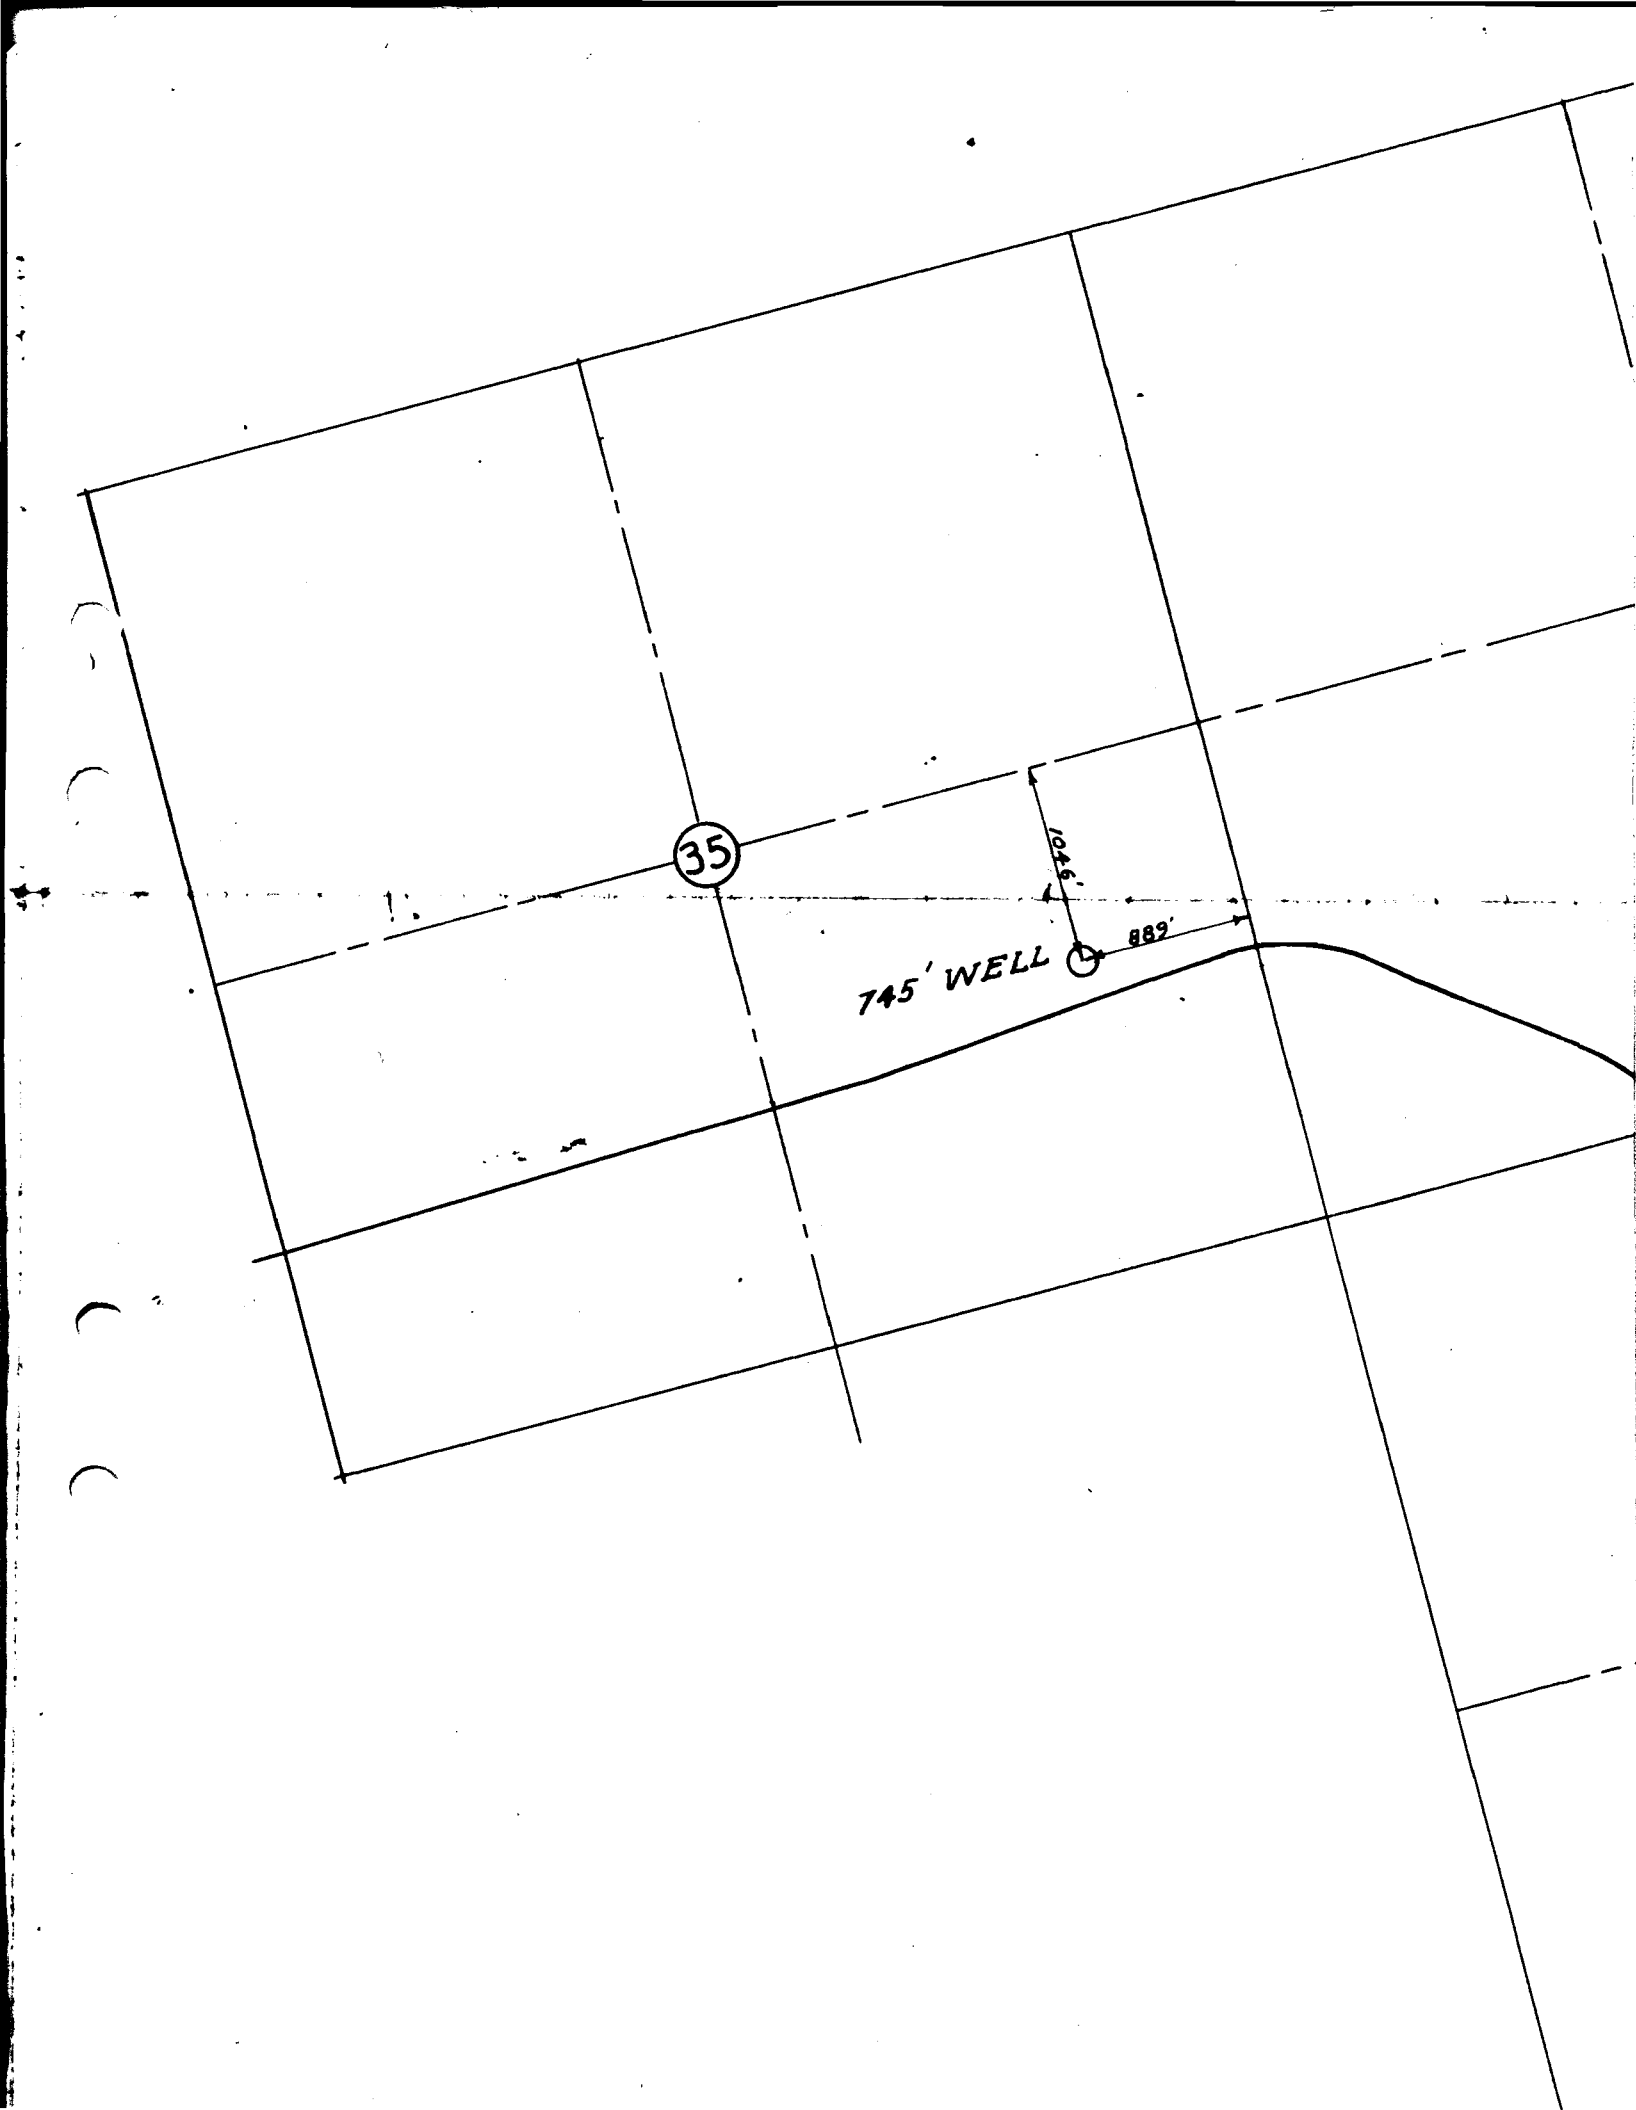

app G-1397
Pr G-1259

LAKE
CLAMATH
COUNTY

T. 24 S. R. 11 E.

T. 25 S. R. 11 E.

T. 25 S. R. 12 E.

36

1

6

G-1397

G-1259

