


# T. 33S. R. 7½E. W.M.

WOOD RIVER ADJ.  
T. 33S. R. 6E. W.M.  
NW¼ SW¼  
SEC. 24

BLUE SPRINGS

Div. Pt.

BLUE SPRINGS DITCH

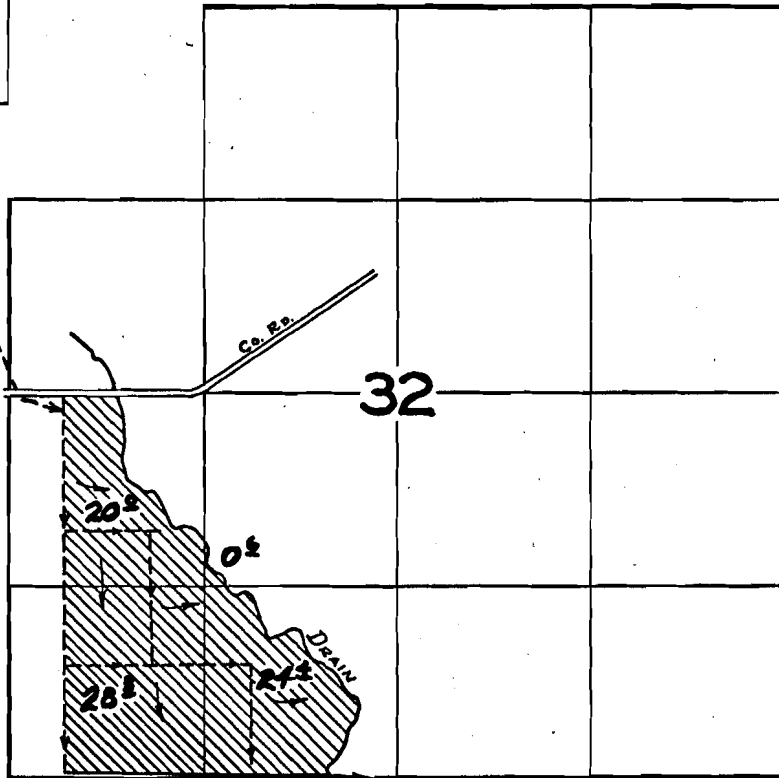


## FINAL PROOF SURVEY UNDER

Application No. 26960 Permit No. 21928  
IN NAME OF

IRA F. & MARIE OREM

Surveyed Oct. 8, 1959, by R. H. JACKSON