


T.6S.R.3W.W.M.

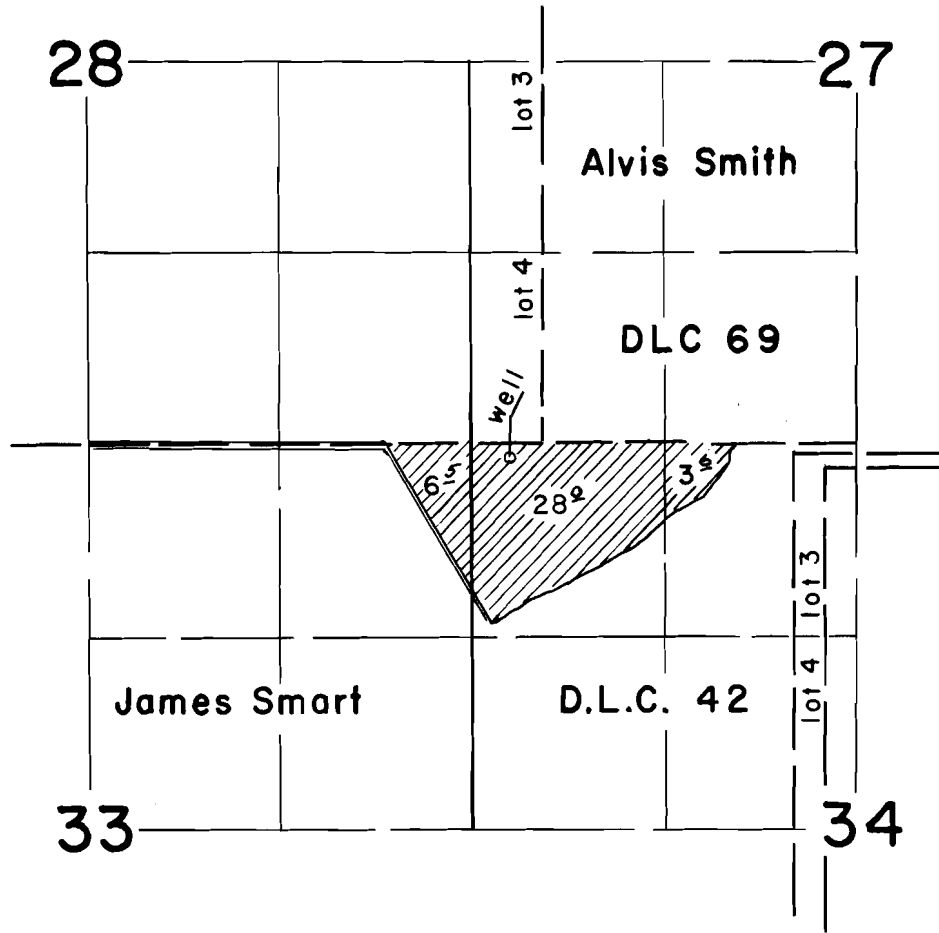

FINAL PROOF SURVEY
UNDER

Application No. G-1628 Permit No. G-1511
IN NAME OF

Wayne L. Weeks

Surveyed April 25 1963, by T. Lauer