


T. 6 S. R. 2 W. W. M.

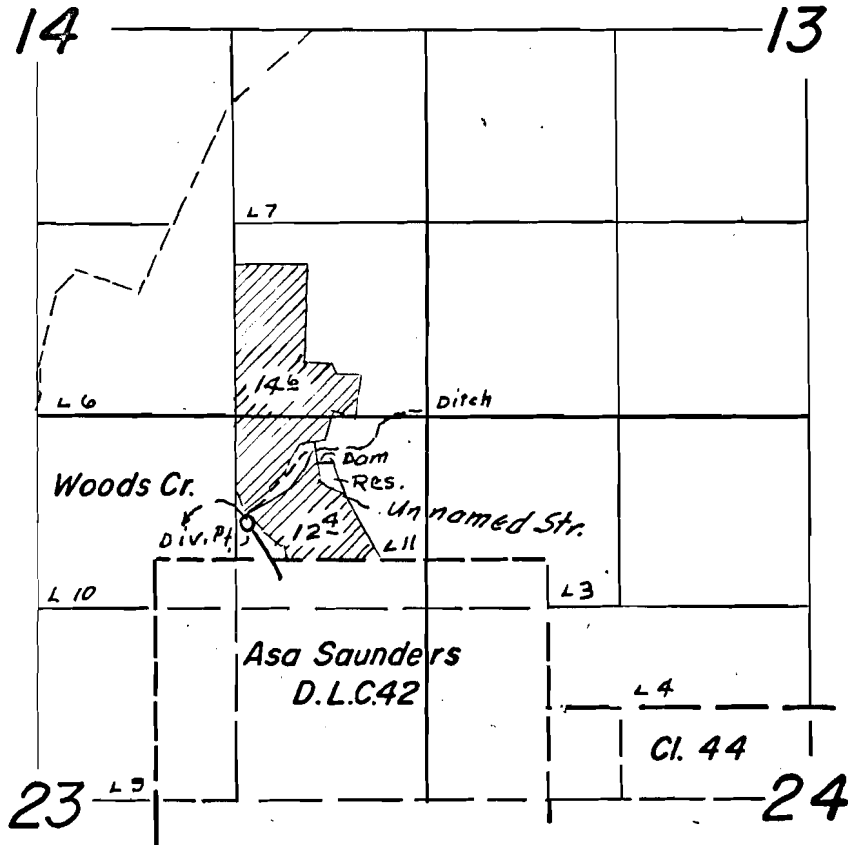

*Glenn  
Graham*

**FINAL PROOF SURVEY**  
UNDER

Application No. 32739 Permit No. 25844  
R-32738 R-2200  
IN NAME OF

George E. McIlwain

Surveyed Aug. 27 1963, by Floyd L. Siegmund