


3213

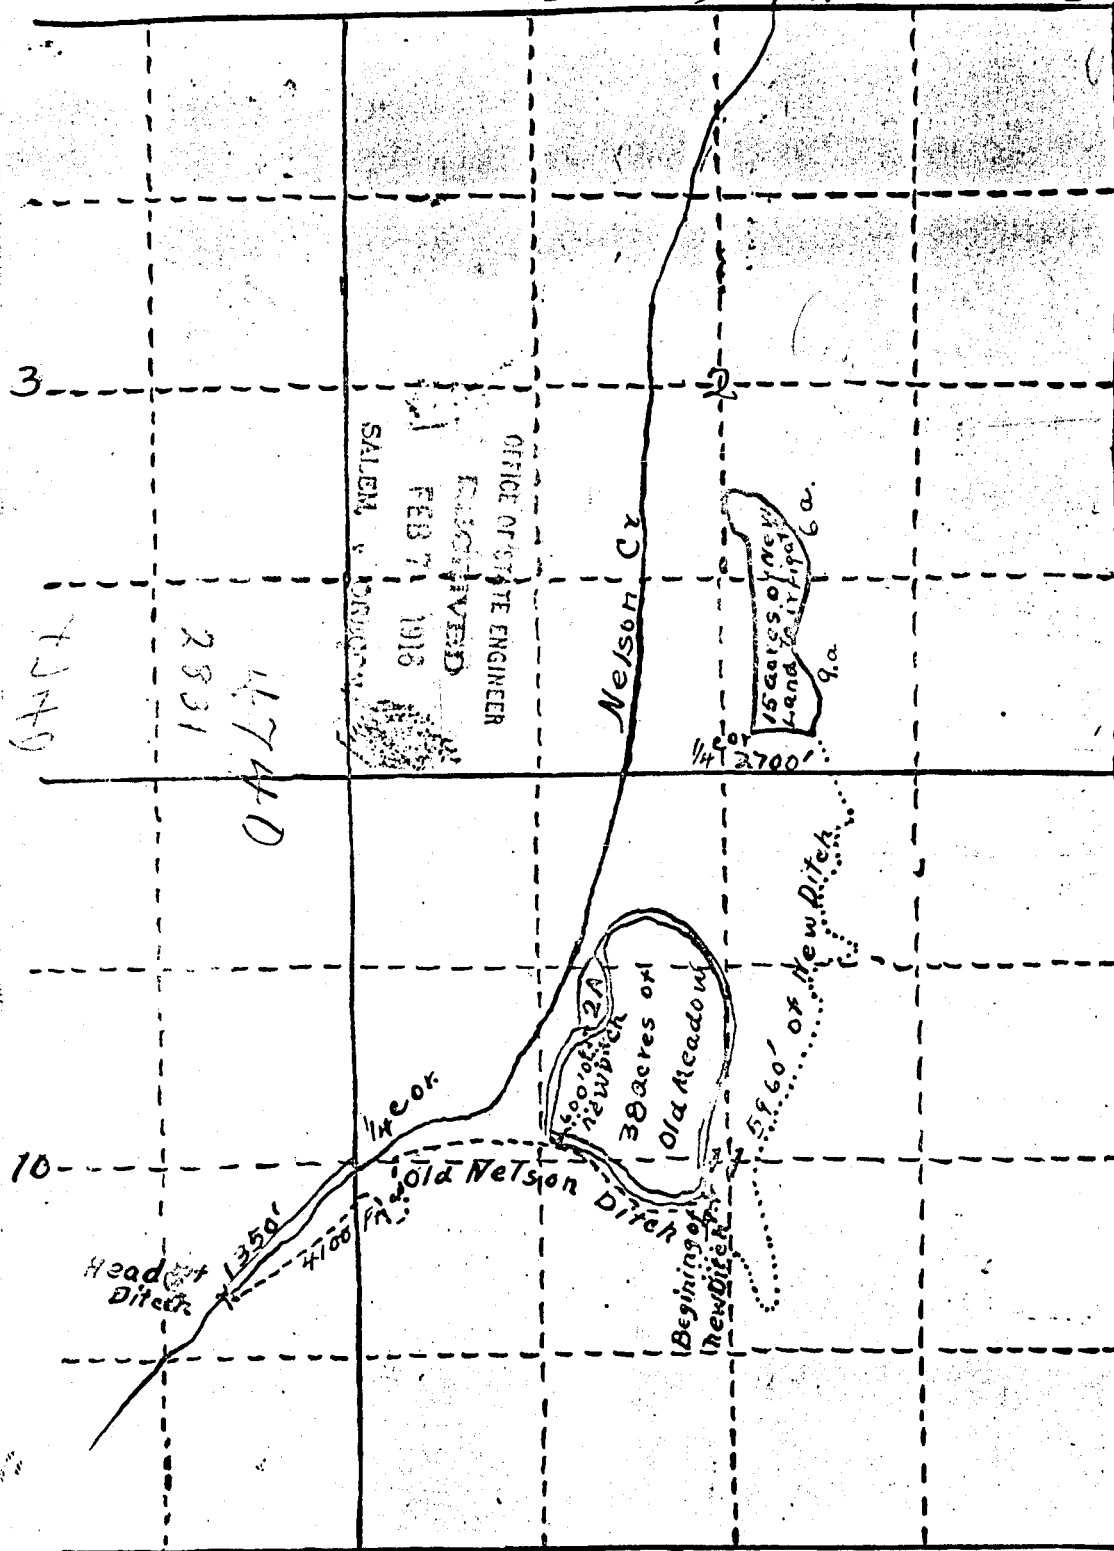

Scale
4" = 12 min

I do certify that this map was made by me from notes taken by an actual field survey

O. M. Greenman
Surveyor.