


T.6S.R.3W.W.M.

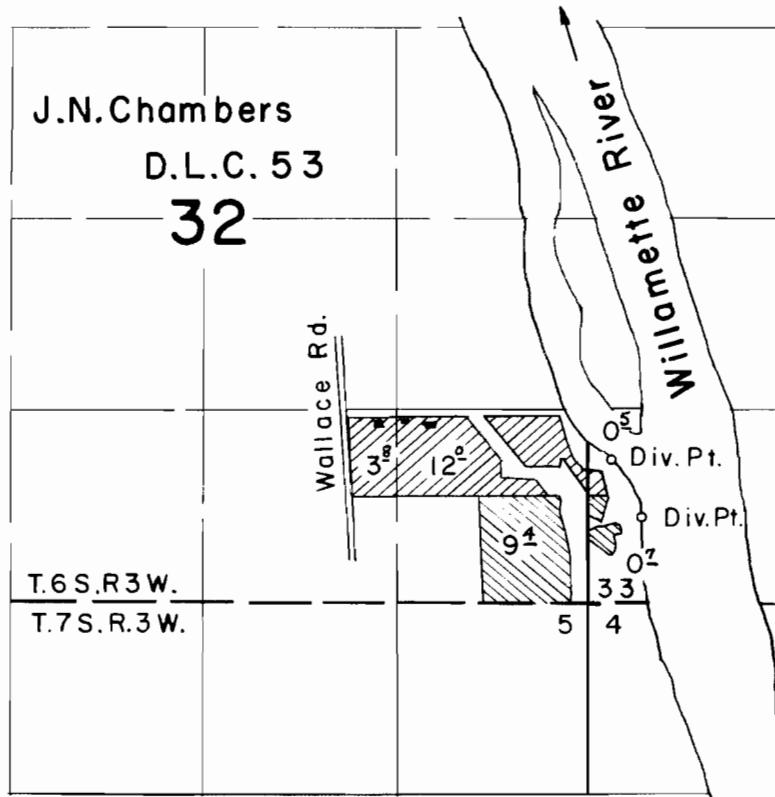

-  Heffly
-  Peterson

FINAL PROOF SURVEY UNDER

Application No. 34237. Permit No. 26958.
IN NAME OF

John C. Heffley & John E. Peterson

Surveyed March 4, 1963, by Floyd L. Siegmund
Oct. 6, 1964