


T. 6 S. R. 10 W. W.M.

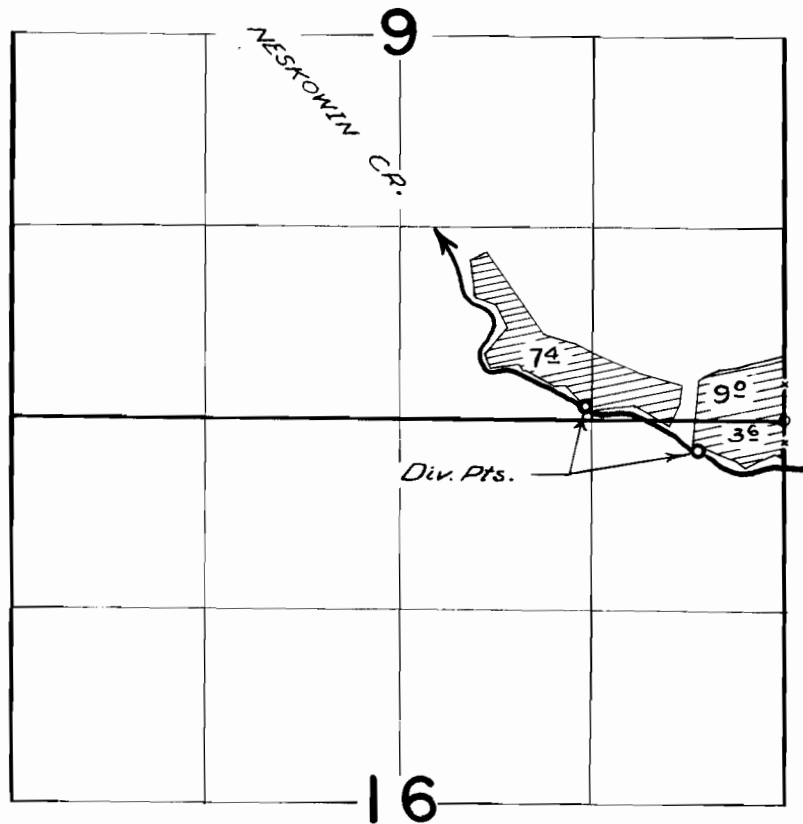

FINAL PROOF SURVEY
UNDER

Application No. 32192 Permit No. 25394
IN NAME OF

ARTHUR E. NAUGHTON

Surveyed JULY 24 1963, by C. BAKER