


# T. I. S. R. 4 W. W. M.

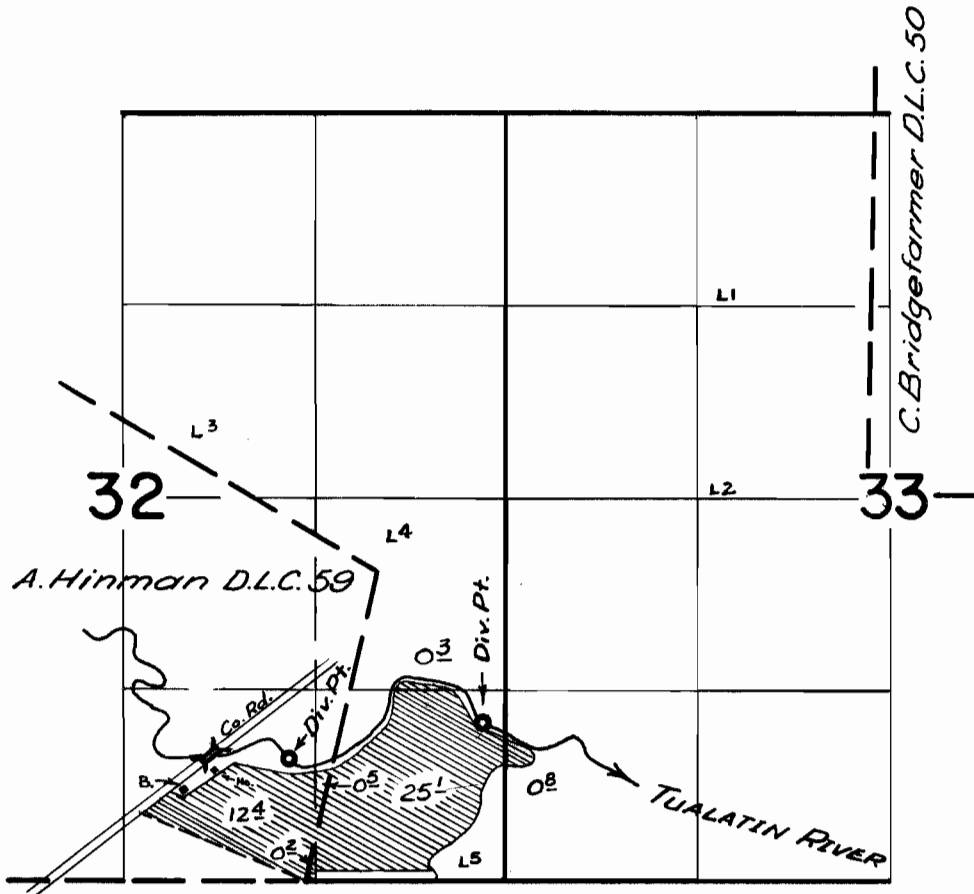

## FINAL PROOF SURVEY UNDER

Application No. 32987 Permit No. 26086  
IN NAME OF

CARL C. HERING

Surveyed MAY 2 1963, by m. Bish