


# T. 2 S. R. 3 W. W.M.

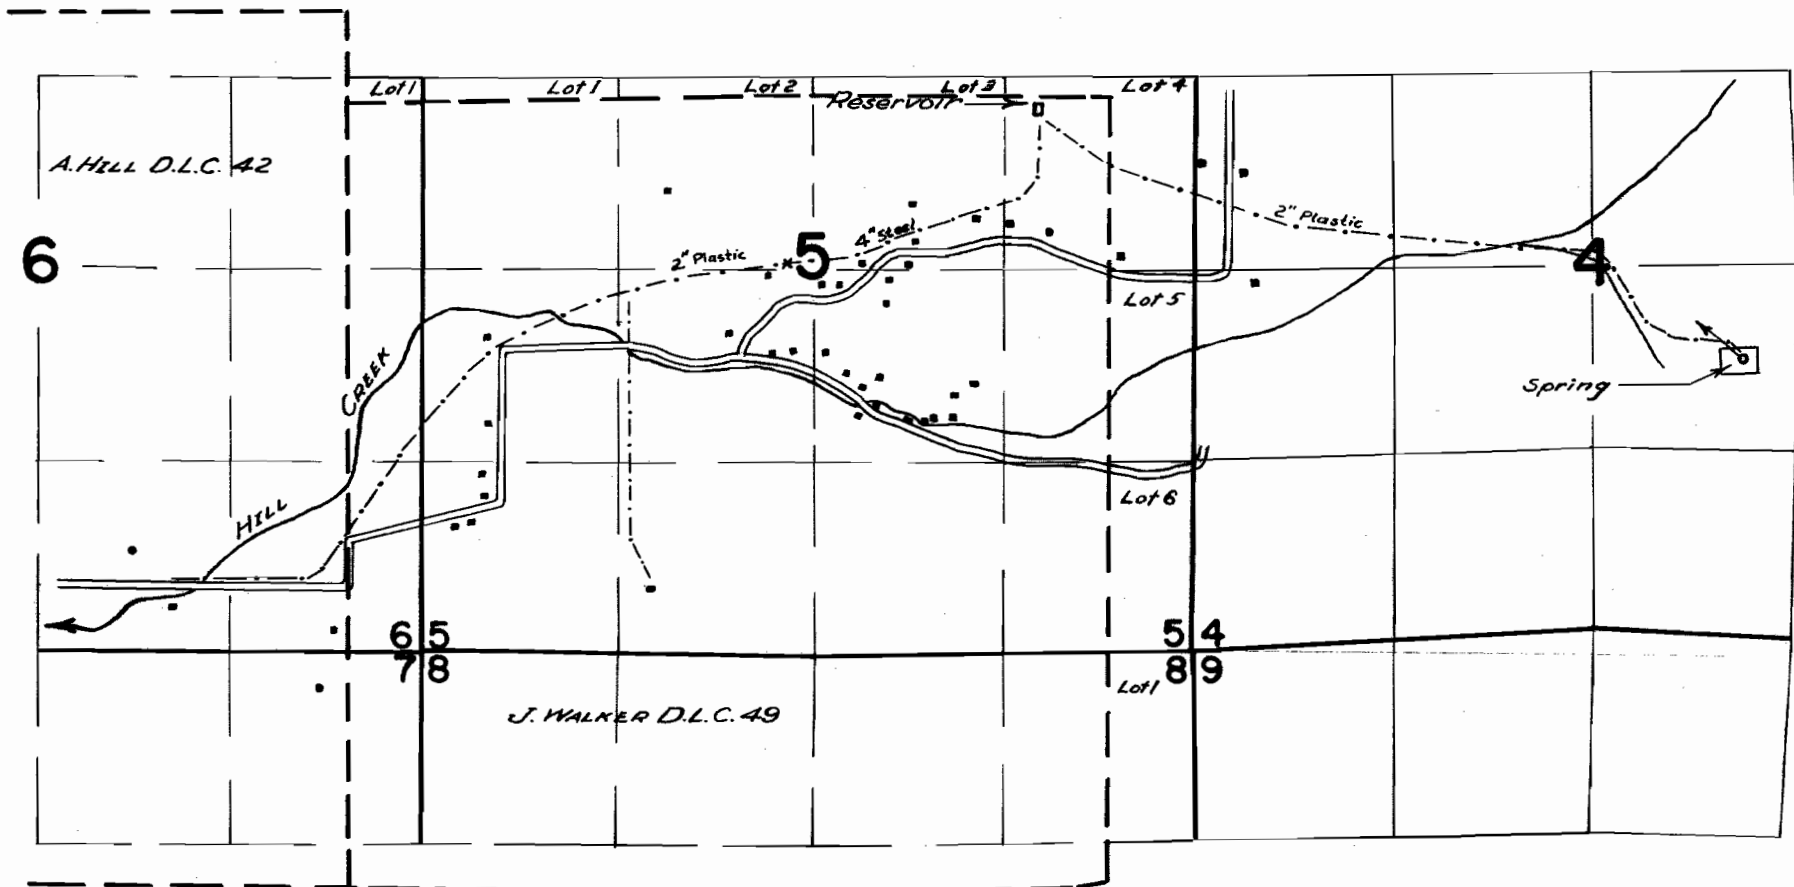

## FINAL PROOF SURVEY UNDER

Application No. 33068 Permit No. 26151  
IN NAME OF

*Laurelwood Water Users Co-operative*

Surveyed April 23, 1963, by *Tm. Bish*