


T. 2 S. R. 2 W. W. M.

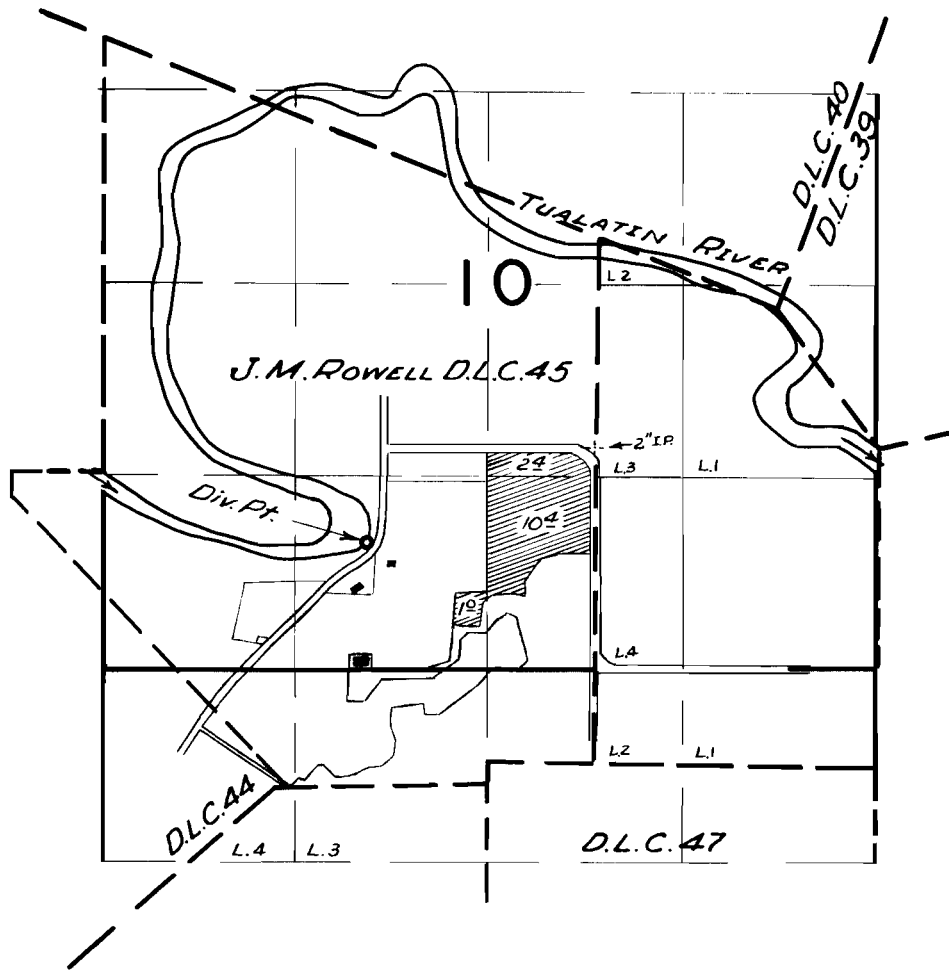

FINAL PROOF SURVEY
UNDER

Application No. 37621 Permit No. 28055
IN NAME OF

FRANK LILLEGARD

Surveyed MAR. 28 1963, by *M. B. Bick*