


T. 5 S. R. 5 W. W. M.

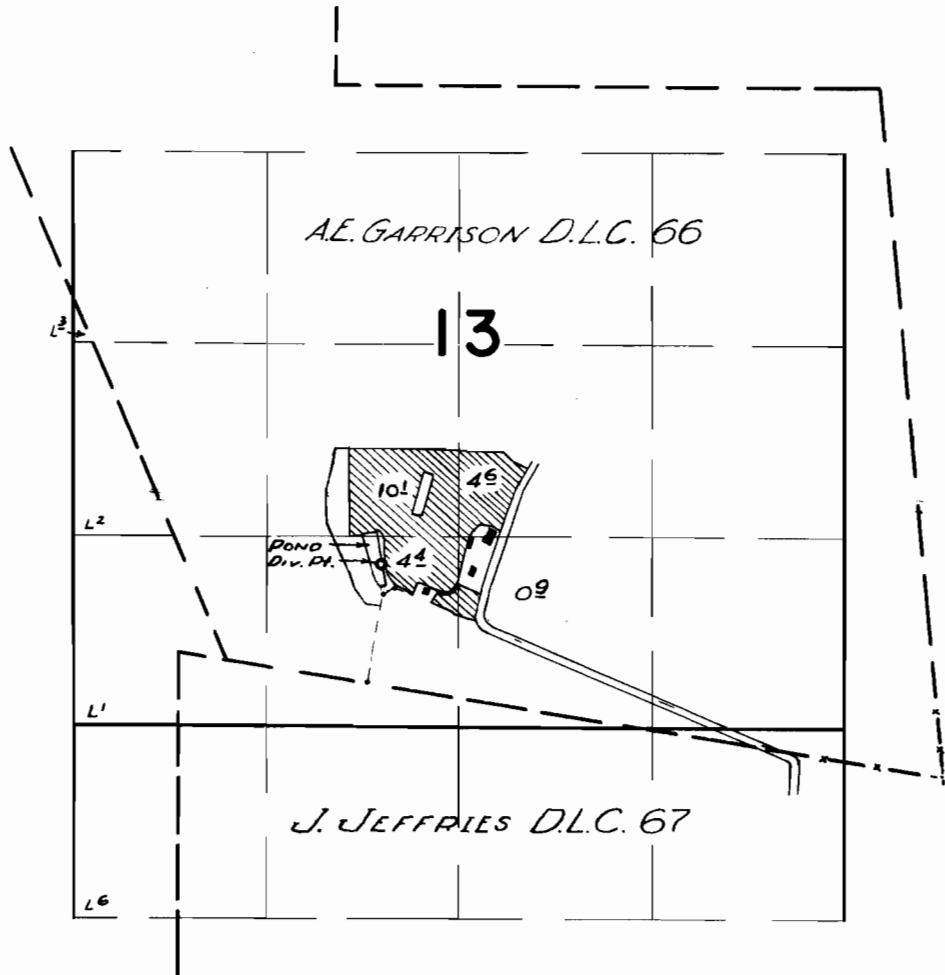

FINAL PROOF SURVEY
UNDER

Application No. G-1889 32746 Permit No. G-1728 25892
IN NAME OF

ESTATE OF MINNIE SHELDON

Surveyed MAY 17 1963, by m. Bish