


T. 5 S. R. 5 W. W. M.

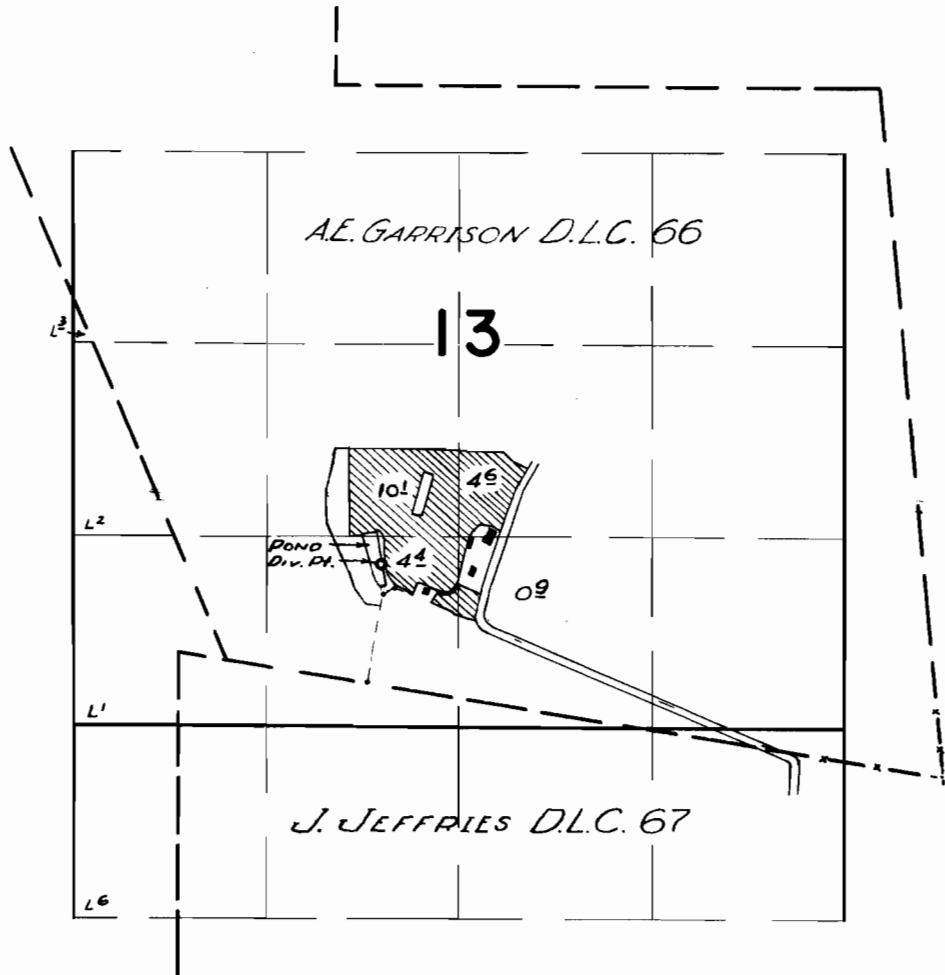

**FINAL PROOF SURVEY**  
UNDER

Application No. G-1889 32746 Permit No. G-1728 25892

IN NAME OF  
**ESTATE OF MINNIE SHELDON**

Surveyed MAY 17 1963, by m. Bish