


T.4S.R.5W.W.M.

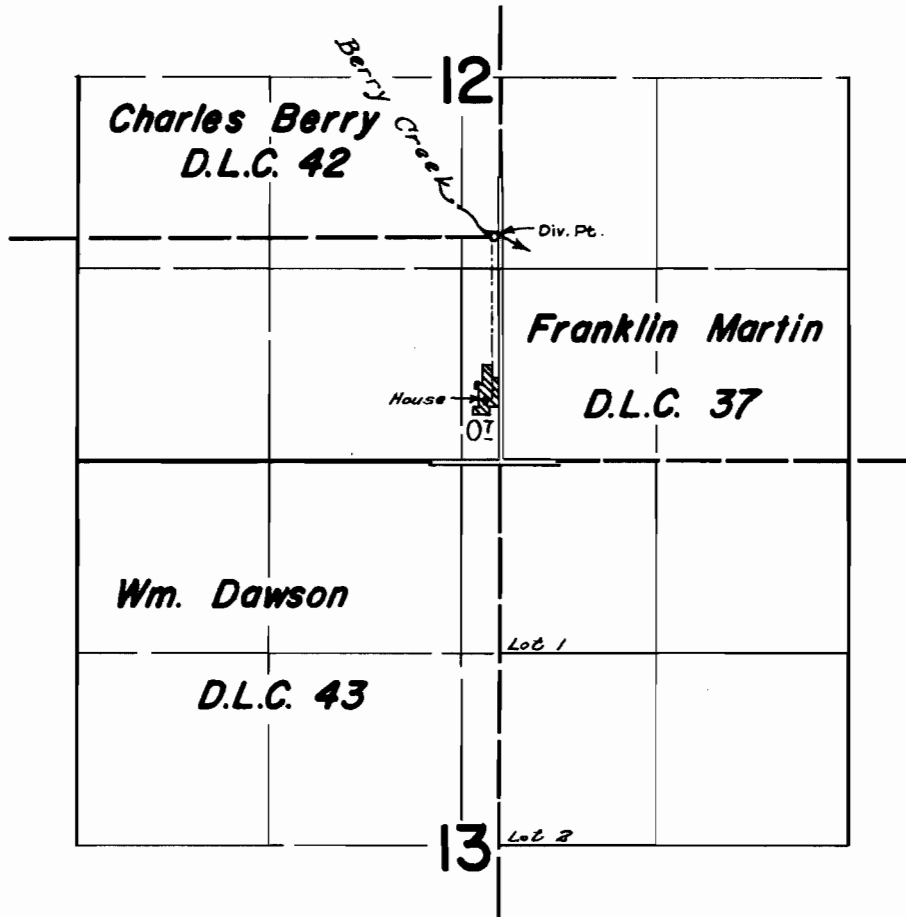

FINAL PROOF SURVEY UNDER

Application No. ³⁸⁸¹⁹ 33174 Permit No. ²⁸⁸⁸⁸ 26239
IN NAME OF

LEE R. & CELIA E. MALONEY

Surveyed August 28 1962, by *R. H. Jackson*